IREDELL COUNTY HEALTH DEPARTMENT

Statesville Office (704) 878-5305 Mooresville Office (704) 660-3625 PERMIT # 208273

IMPROVEMENT PERMIT / AUTHORIZATION TO CONSTRUCT / OPERATION PERMIT / EXISTING SYSTEM

PIN # 4830003309

APPLICANT: James R Garreau APPLICANT ADDRESS: 115 Dobson Farm Rd Statesville NC

SITE ADDRESS: 115 Dobson Farm Rd Statesville NC PHONE: 815-931-9868 ALT. PHONE: N/A

SITE DIRECTIONS: 115 N T/R Hams Grove T/L N Chipley Ford Rd T/L Dobson Farm Rd 1st Drive on left

SUBDIVISION: J E King Farm SECTION: M1 LOT # 30 LOT AREA: 14.017ac DESIGN FLOW: 360 L.T.A.R.: Ex

Septic Tank Ex (gal) STB Date

Pump Tank (gal) PT Date

Pump Make Model Serial #

Nitrification Fields Ex # Lines Ex Linear Ft: Ex

Trench Width Ex Max. Trench Bottom Depth Ex Gravel Depth N/A

☐ New System ☐ Repair ☐ Expansion System Type: I II [III] IV V VI

System Description: Existing

Repair System Description:

Maintenance Agreement Required: ☐ YES ☒ NO

☒ GRAVITY ☐ PRESSURE

☒ Residence No. Bedrooms 3

☐ Business No. Persons 6

☐ Other No. Employees


☐ Slab ☒ Crawl Space

☐ Basement w/plumbing ☐ Basement w/o plumbing


Water Supply: ☒ Private ☐ Public ☐ Community

Comments / Conditions: All building foundations must be 35' from any part of STS and 25' from any well.

INITIAL SITE SKETCH

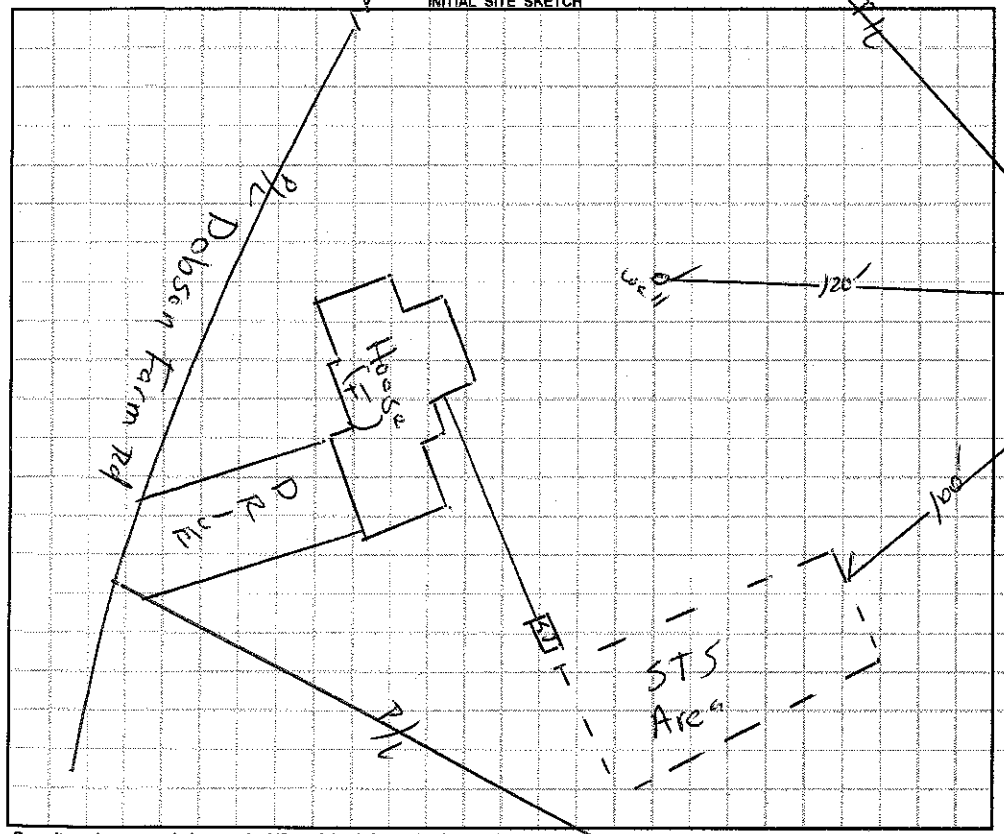

AS BUILT SKETCH

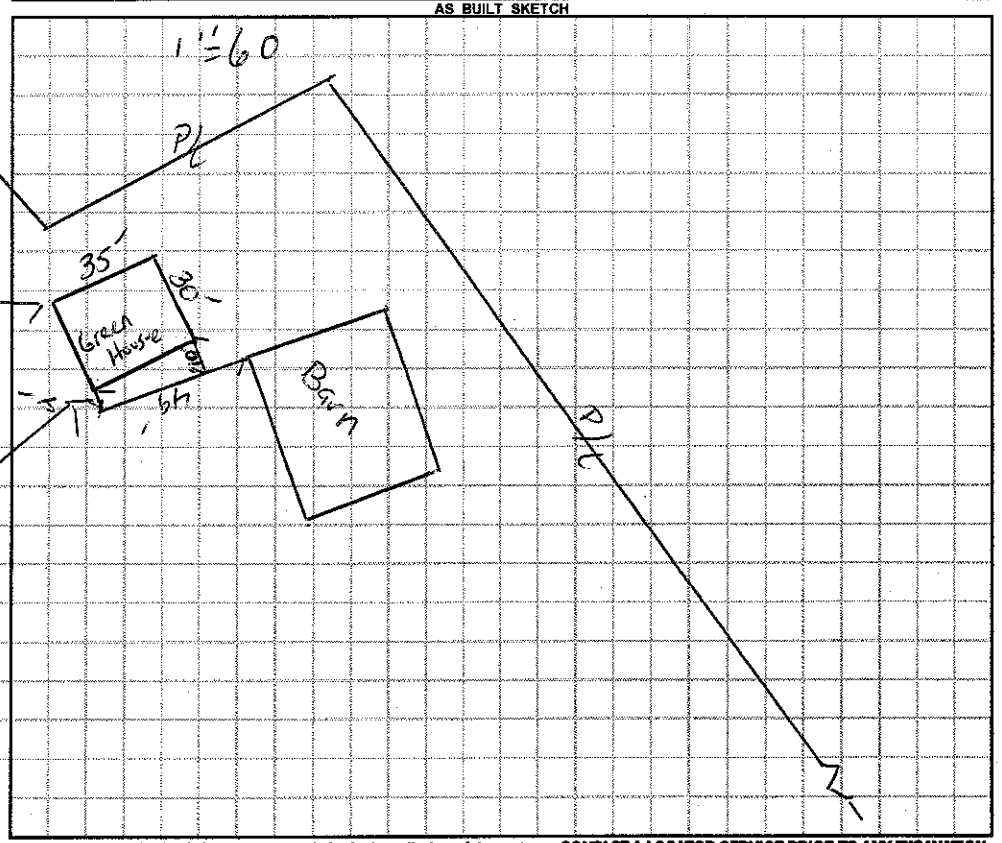

Permit can be suspended or revoked if any false information is supplied toward securing the permit / any unauthorized changes are made to the site / any unauthorized changes are made in the installation of the system. **CONTACT A LOCATOR SERVICE PRIOR TO ANY EXCAVATION**

☐ **IMPROVEMENT PERMIT** *with plat valid without expiration.* ☐ **IMPROVEMENT PERMIT** *with site plan valid for 60 mos.* ☐ **AUTHORIZATION TO CONSTRUCT** *valid for period equal to IMPROVEMENT PERMIT--not to exceed 60 mo.*

Owner / Applicant Signature: James R Garreau Date: 2-13-15 Installed by:

IMPROVEMENT PERMIT by: Date: OPERATION PERMIT by: Date:

AUTHORIZATION TO CONSTRUCT by: Date: Existing System Inspected by: Date: 02/13/15

Health Dept. Copy - WHITE Applicant (Final Approval) - YELLOW Applicant (Conditional Approval) - PINK

IREDELL COUNTY HEALTH DEPARTMENT

Statesville Office (704) 878-5305 Mooresville Office (704) 660-3625 PERMIT # 20230

IMPROVEMENT PERMIT / AUTHORIZATION TO CONSTRUCT / OPERATION PERMIT / EXISTING SYSTEM

PIN # 4830002496

APPLICANT: James Garrear APPLICANT ADDRESS: 115 Dobson Farm Rd.

SITE ADDRESS: 115 Dobson Farm Rd. PHONE: 915-931-9868 ALT. PHONE: N/A


SITE DIRECTIONS: Hwy 115 N TR Hams Grove Rd. TL N. Chipley Ford Rd TL Dobson Farm Rd. 1st Drive on Left

SUBDIVISION: J E KING Farm SECTION: M LOT # 30 LOT AREA: 18.49 acres DESIGN FLOW: 360gpd L.T.A.R.: 0.03


Septic Tank	1000	(gal)	STB	1012	Date	3-17-14	☐ New System	☑ Repair	☐ Expansion	System Type: I II III IV V VI	☑ Residence	No. Bedrooms	3	Water Supply	
Pump Tank	N/A	(gal)	PT	N/A	Date	N/A	System Description:				☐ Business	No. Persons	6	☑ Private	
Pump Make	N/A	Model	Tuftyte		Serial #	EF-4	Repair System Description:	25% Reduction			☐ Other	No. Employees		☐ Public	
# Nitrification Fields	1	# Lines	3		Linear Ft:	300	Maintenance Agreement Required:	☐ YES	☑ NO		☐ Slab	☑ Crawl Space		☐ Community	
Trench Width	36"	Max. Trench Bottom Depth		36"	Gravel Depth	N/A		☑ GRAVITY	☐ PRESSURE		☐ Basement w/plumbing		☐ Basement w/o plumbing		

Comments / Conditions: Install a 25% Reduction system on contour with serial distribution.

INITIAL SITE SKETCH

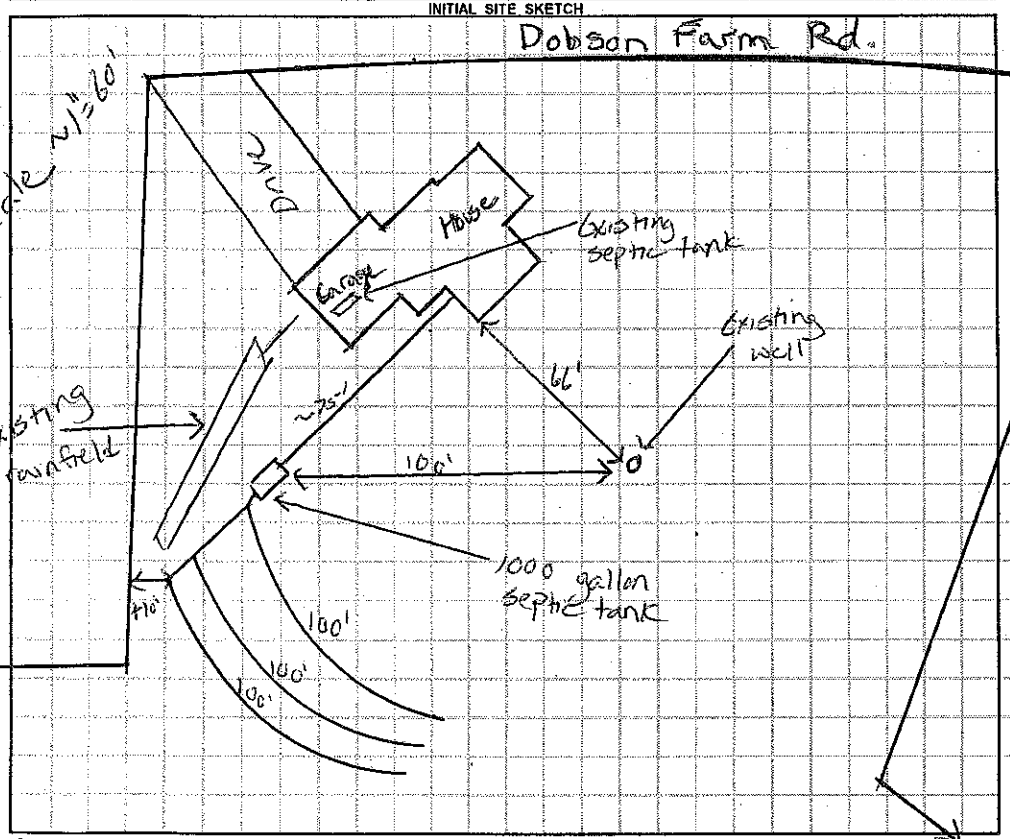

AS BUILT SKETCH

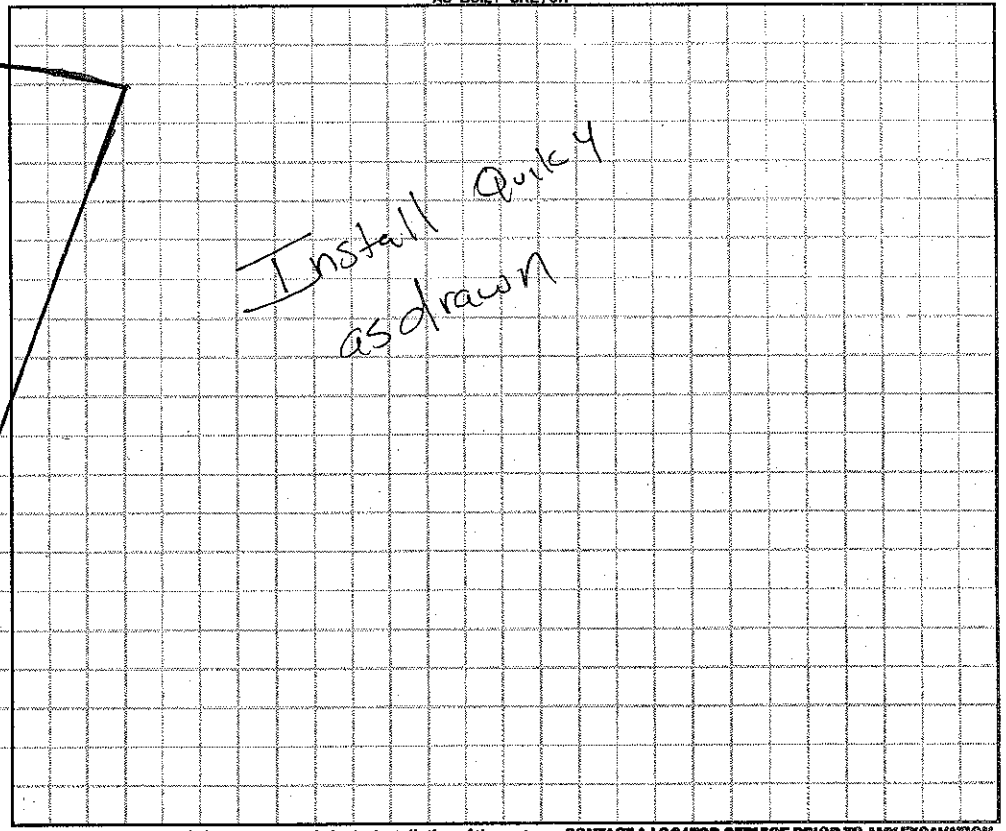

Permit can be suspended or revoked if any false information is supplied toward securing the permit / any unauthorized changes are made to the site / any unauthorized changes are made in the installation of the system. **CONTACT A LOCATOR SERVICE PRIOR TO ANY EXCAVATION**

☐ **IMPROVEMENT PERMIT** *with plat valid without expiration.* ☑ **IMPROVEMENT PERMIT** *with site plan valid for 60 mos.* ☑ **AUTHORIZATION TO CONSTRUCT** *valid for period equal to IMPROVEMENT PERMIT--not to exceed 60 mo.*

Owner / Applicant Signature: James R Garrear Date: 4-17-14 Installed by: Steve Jordon

IMPROVEMENT PERMIT by: Justin Henderson Date: 4-2-14 OPERATION PERMIT by: Robert H Shaw Date: 06/03/14

AUTHORIZATION TO CONSTRUCT by: Justin Henderson Date: 4-2-14 Existing System Inspected by: Date:

Health Dept. Copy - WHITE Applicant (Final Approval) - YELLOW Applicant (Conditional Approval) - PINK