IREDELL COUNTY HEALTH DEPARTMENT

STATESVILLE 704-878-5305 MOORESVILLE 704-664-5281

IMPROVEMENT PERMIT / AUTHORIZATION TO CONSTRUCT / OPERATION PERMIT / EXISTING SYSTEM INSPECTION

PERMIT# 118046 PIN# 4830-00-7394 DATE 2/16/2004

OWNER OR CONTRACTOR WAYNE HOMES MID ATLANTIC, LLC PHONE: Business 704-872-8989 Home

ADDRESS 130 VICTORY LANE STATESVILLE 28625

LOCATION HWY 115N (R) HAMS GROVE RD LOT ON (L) BEFORE N CHIPLEY FORD RD.

SUBDIVISION JE KING BLOCK / SECTION LOT 2 LOT AREA .54 SITE CLASS. PS DESIGN FLOW 360 L.T.A.R. .3 GPD/FT²

Septic Tank: 1000 Gallons; STB 1012 Date 12-30-03
Pump Tank: Gallons; PT Date
Pump Make: Model Serial No.
Nitrification Field: No Fields 1 Square Feet 1200 Linear Feet 400
No Lines 5 Trench Width 36" Max Trench Bottom Depth 24" Gravel Depth 12"

☑ New System ☐ Repair System Type: I (II) III, IV, V, VI
System Description: CONVENTIONAL GRAVITY
Repair System Description: LP PANEL 50% RED.
Maintenance Agreement Required: ☐ Yes ☑ No

☐ House/Mod. Home No. Bedrooms 3
☐ Mobile Home No. Bathrooms 2
☐ Business No. Employees
☐ Other


☐ Slab ☑ Crawl Space ☐ Basement w/plumbing ☐ Basement wo/plumbing

Water Supply: ☐ Individual ☑ Public ☐ Community


Comments/Conditions: ① INSTALL ACCORDING TO SKETCH ② MUST MAINTAIN 15' SETBACK FROM FRENCH DRAIN ③ FRENCH DRAIN MUST BE INSTALLED @ 36" AND DRAINFIELD @ 24"

Comments/Conditions: ① Toff-site filter ② #57 stone ③ Tank has 18" riser ④ French drain installed at 36" around system to daylight

INITIAL SITE SKETCH

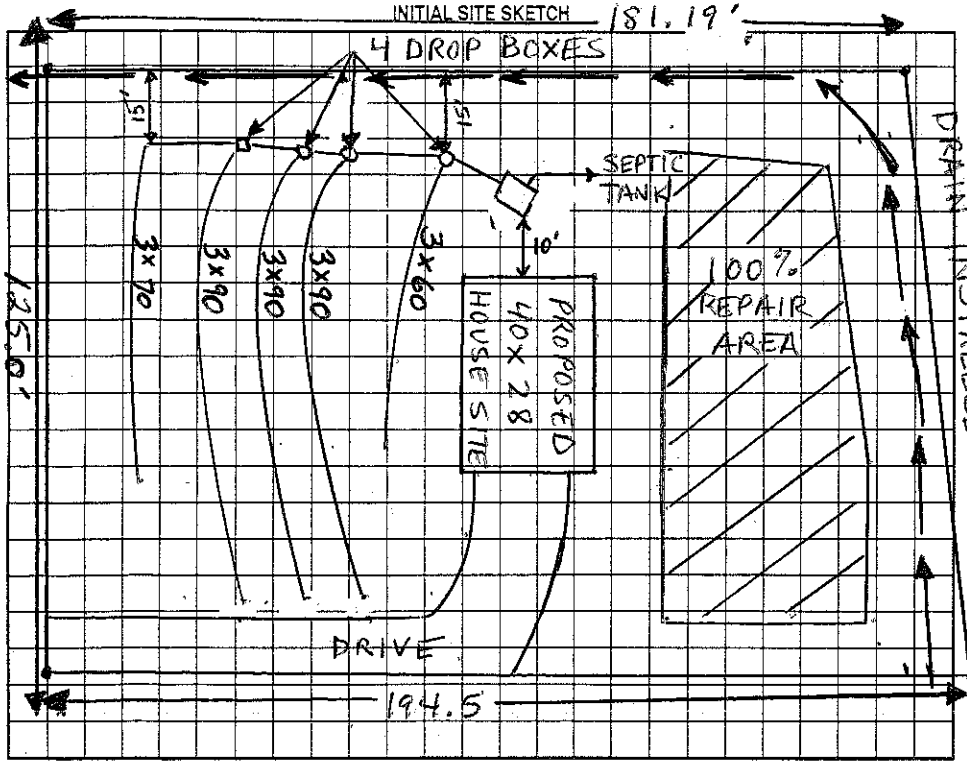

AS BUILT SKETCH

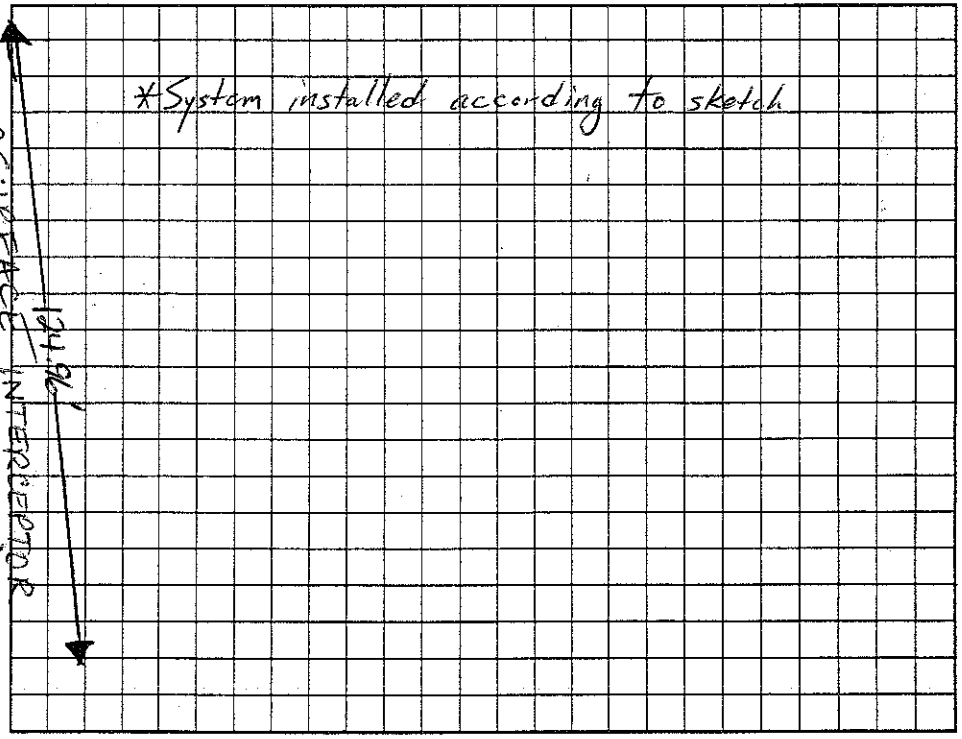

Permit can be suspended or revoked if any false information is supplied toward securing the permit/any unauthorized changes are made to the site/any unauthorized changes are made in the installation of the system. Improvement Permit with plat valid without expiration. Improvement Permit with site plan valid for sixty months. Authorization to Construct is valid for a period equal to that of Improvement Permit – not to exceed sixty months.

Signed: Scott Cuthbertson date 2-16-04 Installed by: A-1 Backhoe

Improvement Permit by: Christopher M. Sherrill RS date 2-16-04 Operation Permit by: Christopher M. Sherrill, RS date 6/4/04

Authorization to Construct by: Christopher M. Sherrill, RS date 2-16-04 Existing System Inspection by: date

HEALTH DEPT. COPY: WHITE OWNER COPY (FINAL): YELLOW OWNER COPY (INITIAL): PINK