IREDELL COUNTY HEALTH DEPARTMENT

Statesville Office (704) 878-5305 Mooresville Office (704) 660-3625 PERMIT # 20726 3

IMPROVEMENT PERMIT / AUTHORIZATION TO CONSTRUCT / OPERATION PERMIT / EXISTING SYSTEM

PIN # 4830268951

APPLICANT: Goodman Family LP APPLICANT ADDRESS: 1030 Friendship Rd.

SITE ADDRESS: 927 N Chipley Ford Rd. PHONE: 704-880-7540 ALT. PHONE: N/A


SITE DIRECTIONS: Hwy 115 N TR Friendship Rd TR N. Chipley Ford Rd. Property on Right

SUBDIVISION: N/A SECTION: N/A LOT # N/A LOT AREA: 178.55 acres DESIGN FLOW: 240 gpd L.T.A.R.: 0.25

Septic Tank 1000 (gal)	STB 620/1060	Date 3-5-14	☑ New System ☐ Repair ☐ Expansion	System Type: I (II) III IV V VI	☑ Residence	No. Bedrooms 2	Water Supply
Pump Tank (gal)	PT	Date	System Description: Conventional		☐ Business	No. Persons 4	☐ Private
Pump Make	Model	Serial #	Repair System Description: Conventional		☐ Other	No. Employees	☑ Public
# Nitrification Fields 1	# Lines 3	Linear Ft: 320	Maintenance Agreement Required: ☐ YES ☑ NO		☐ Slab	☑ Crawl Space	☐ Community
Trench Width 36"	Max. Trench Bottom Depth 36"	Gravel Depth 12"	☑ GRAVITY ☐ PRESSURE		☐ Basement w/plumbing	☐ Basement w/o plumbing	

Comments / Conditions: Install a Conventional system on contour with serial distribution.

INITIAL SITE SKETCH

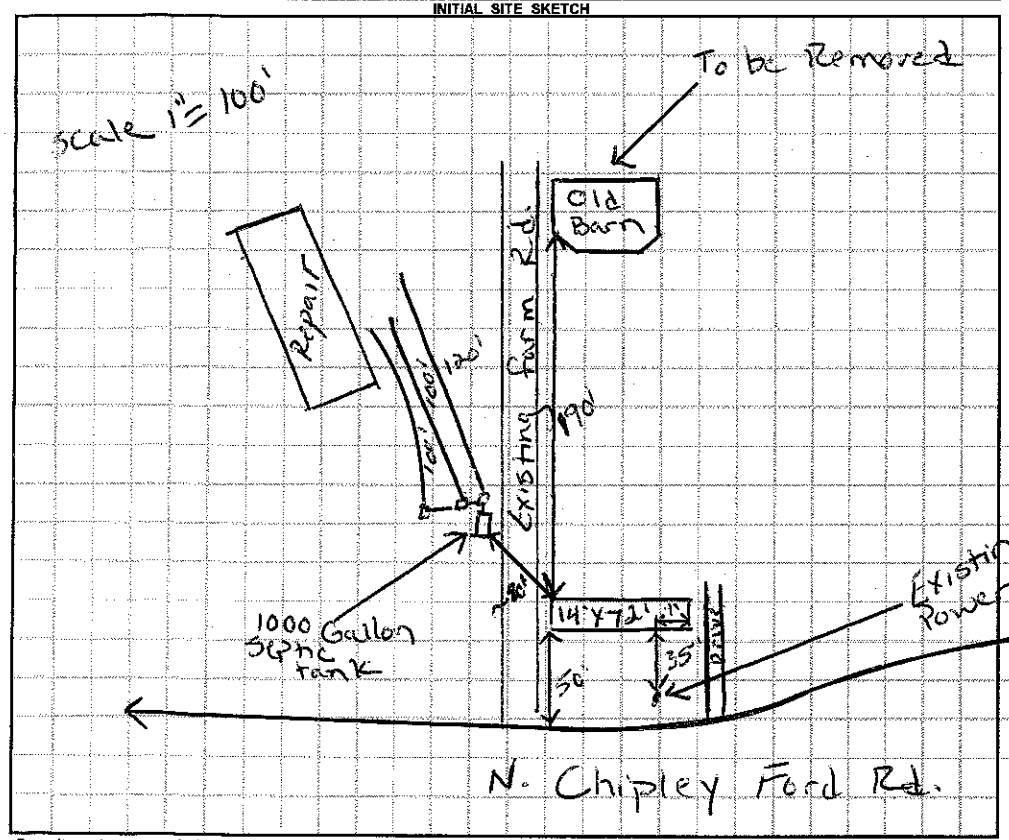

AS BUILT SKETCH

- Yellow Turf tile filter installed
- Drainfield installed during rain event
- Conventional system installed as drawn.

Permit can be suspended or revoked if any false information is supplied toward securing the permit / any unauthorized changes are made to the site / any unauthorized changes are made in the installation of the system. **CONTACT A LOCATOR SERVICE PRIOR TO ANY EXCAVATION**

☐ **IMPROVEMENT PERMIT** *with plat valid without expiration.* ☑ **IMPROVEMENT PERMIT** *with site plan valid for 60 mos.* ☑ **AUTHORIZATION TO CONSTRUCT** *valid for period equal to IMPROVEMENT PERMIT--not to exceed 60 mo.*

Owner / Applicant Signature: [signature] Date: 1-2-15 Installed by: Kenny Madison

IMPROVEMENT PERMIT by: Justin Henderson Date: 2-31-14 OPERATION PERMIT by: Justin Henderson Date: 1-28-15

AUTHORIZATION TO CONSTRUCT by: Justin Henderson Date: 1-2-15 Existing System Inspected by: Date:

Health Dept. Copy - WHITE Applicant (Final Approval) - YELLOW Applicant (Conditional Approval) - PINK