IREDELL COUNTY HEALTH DEPARTMENT

Statesville Office (704) 878-5305 Mooresville Office (704) 660-3625 PERMIT # 178355

IMPROVEMENT PERMIT / AUTHORIZATION TO CONSTRUCT / OPERATION PERMIT / EXISTING SYSTEM

PIN # 4830362689

APPLICANT: Jerry Harmon APPLICANT ADDRESS: [redacted] 853 N. Chipley Ford Rd.

SITE ADDRESS: 865 N. Chipley Ford Rd. PHONE: 704-929-5783 ALT. PHONE: N/A


SITE DIRECTIONS: Hwy 115 N TR Hams Grove Rd TL N. Chipley Ford Rd. Property on Left

SUBDIVISION: N/A SECTION: N/A LOT # N/A LOT AREA: 3.4 acres DESIGN FLOW: 240 gpd L.T.A.R.: 0.3

Septic Tank	1000	(gal)	STB	1012	Date	11-5-12	☑ New System	☐ Repair	☐ Expansion	System Type: I II (III) IV V VI	☑ Residence	No. Bedrooms	1	Water Supply	
Pump Tank		(gal)	PT		Date		System Description:	25% Reduction			☐ Business	No. Persons		☑ Private	
Pump Make			Model		Serial #		Repair System Description:	25% Reduction			☐ Other	No. Employees		☐ Public	
# Nitrification Fields	1	# Lines	2		Linear Ft:	200	Maintenance Agreement Required:	☐ YES	☑ NO		☐ Slab	☐ Crawl Space		☐ Community	
Trench Width	36"	Max. Trench Bottom Depth	30"		Gravel Depth	N/A	☑ GRAVITY	☐ PRESSURE			☐ Basement w/plumbing			☑ Basement w/o plumbing	

Comments / Conditions: Improvements ONLY; Submit recorded easement prior to issuance of CA. Install a 25% Reduction system on contour with serial distribution

INITIAL SITE SKETCH

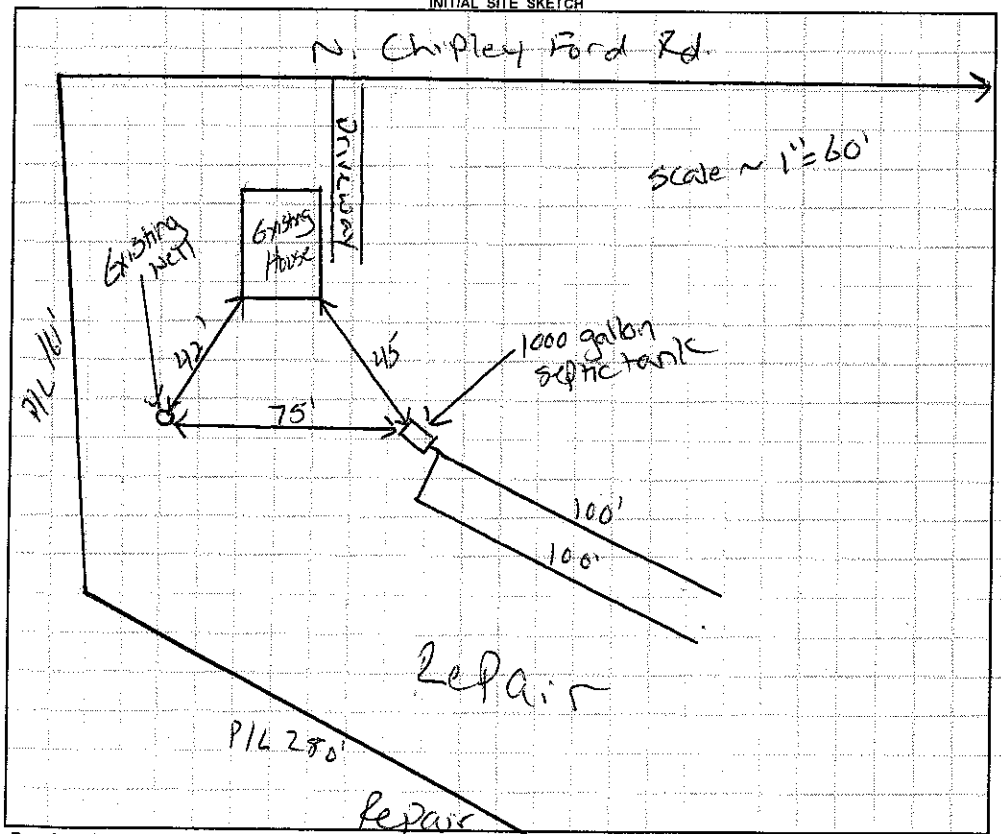

AS BUILT SKETCH

Permit can be suspended or revoked if any false information is supplied toward securing the permit / any unauthorized changes are made to the site / any unauthorized changes are made in the installation of the system. CONTACT A LOCATOR SERVICE PRIOR TO ANY EXCAVATION

☐ IMPROVEMENT PERMIT *with plat* valid without expiration. ☑ IMPROVEMENT PERMIT *with site plan* valid for 60 mos. ☑ AUTHORIZATION TO CONSTRUCT valid for period equal to IMPROVEMENT PERMIT--not to exceed 60 mo.

Owner / Applicant Signature: Jerry Harmon Date: 8-29-13 Installed by: Tim Call

IMPROVEMENT PERMIT by: Justin Henderson Date: 6-12-13 OPERATION PERMIT by: [signature] Date: 9-6-13

AUTHORIZATION TO CONSTRUCT by: Justin Henderson Date: 8-29-13 Existing System Inspected by: Date:

Health Dept. Copy - WHITE Applicant (Final Approval) - YELLOW Applicant (Conditional Approval) - PINK