IREDELL COUNTY HEALTH DEPARTMENT

Statesville Phone TR 3-7271 Mooresville Phone NO 3-1271

PERMIT TO INSTALL SEPTIC TANK

Permit No. 388 Permit Date 6-4 1971

Owner NORTH IREDELL REC. CLUB Address R.5-STATESVILLE

Installed By ADAMS Address TAYLORSVILLE, NC


Location of Property CHIPLEY FORD ROAD - NORTH OF SNOW CREEK RD. 1ST ROAD TO RIGHT - CROSS CREEK - 1 MILE ON RIGHT

Tank		Capacity		Length of Lines		Fixtures	
Block	( )	1000	( )	225'	( )	No. of Baths	( )
Precast	(✓)	1250	(✓)	250'	( )	Dishwasher	( )
		1500	( )	Other 400		Garbage Grdr.	( )
		Other				Other	

NOTIFY HEALTH DEPARTMENT AT LEAST EIGHT HOURS BEFORE TANK IS TO BE INSPECTED.

Final Inspection 6-4 1971 Approved (✓) Disapproved ( )

Remarks

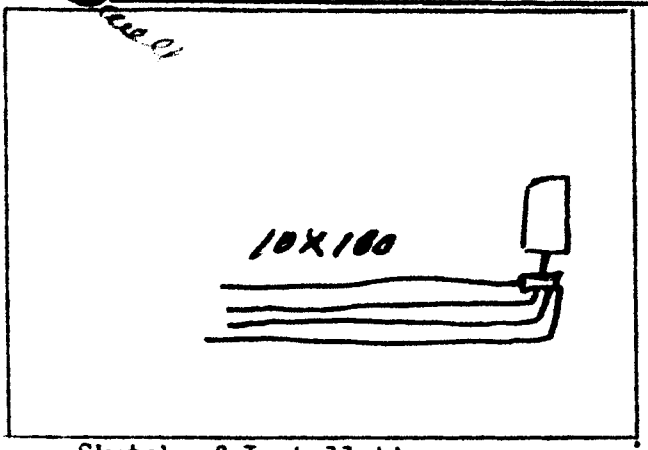

Sketch of Installation

Glenn Fox Jr.

Sanitarian