51045

IREDELL COUNTY HEALTH DEPARTMENT

STATESVILLE 704-878-5305 MOORESVILLE 704-664-5281

IMPROVEMENT PERMIT / CERTIFICATE OF COMPLETION / OPERATION PERMIT / EXISTING SYSTEM INSPECTION

PROPERTY DESCRIPTION NO 17556 DATE 1/24/94 TAX MAP NO 13N-A-30 Watershed [ ] Yes [X] No

OWNER OR CONTRACTOR DEAN DENHAM PHONE: Business Home 876-2825

ADDRESS RT. 5 Box 138-A STATESVILLE NC 28677

LOCATION US 21 N, TL JENNINGS, TL FRIENDSHIP RD, ON (L) ~ 500' BEFORE BEES ROAD

SUBDIVISION BLOCK / SECTION LOT LOT AREA 1.8 AC SITE CLASS PS DESIGN FLOW 100 GPD L.T.A.R. 0.35 GPD/FT²

Septic Tank: 1000 Gallons, STB 1012 Date 3/28/94

Pump Tank: Gallons, PT Date

Pump Make Model Serial No

Nitrification Field, No. Lines 1 Square Feet 285 Linear Feet 95

No Lines 2 Trench Width 36" Max Trench Bottom Depth 18-36" Gravel Depth 12"

[X] New System [ ] Repair System Type I (I, II, V, VI)

System Description: CONV. GRAVITY

Repair System Description: CONV. GRAVITY

Maintenance Agreement Required: [ ] Yes [X] No

[ ] House/Mod. Home No. Bedrooms

[ ] Mobile Home No. Bathrooms

[X] Business No. Employees 1

WHAT 1 EMPLOYEE

[X] Slab [ ] Crawl Space [ ] Basement w/plumbing [ ] Basement wo/plumbing

Water Supply

[X] Individual

[ ] Community


[ ] Public

WELL

Comments: (1) KEEP SYSTEM MINIMUM 5' FROM BLDG, 10' FROM PROPERTY LINE, 100' FROM WELL, OUT OF FILL AREA. (2) INSTALL LINES ON CONTOUR, NO DEEPER THAN 36", 9' ON CENTER

Comments:

INITIAL SITE SKETCH

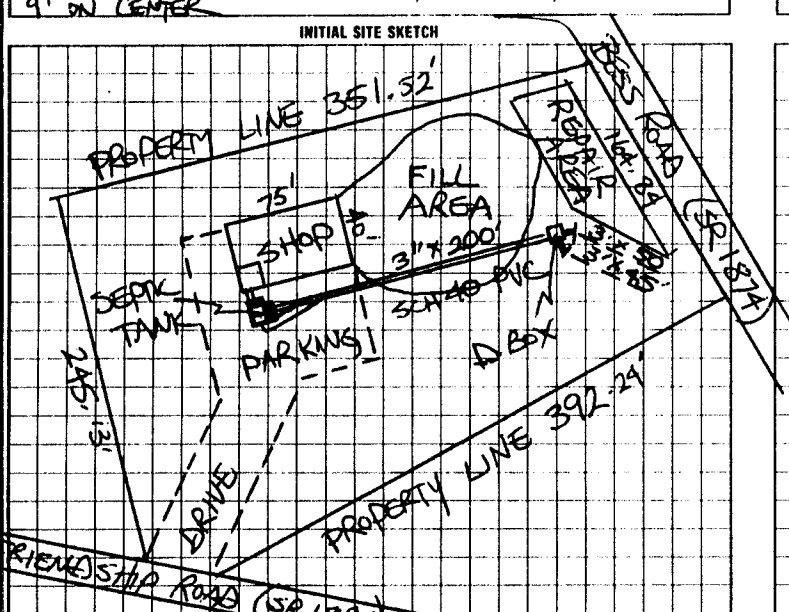

AS BUILT SKETCH

SYSTEM INSTALLED ACCORDING TO INITIAL SITE SKETCH

I understand that this permit can be suspended or revoked if any false information is supplied toward securing the permit/any unauthorized changes are made to the site/any unauthorized changes are made in the installation of the system. Improvement Permit is valid for 60 months from date of issuance.

Signed: J. Dean Denham

Improvement Permit by: STEVE HEDRICK date 1/24/94

Existing System Inspection by: date

Installed by: TOMMY FRYE

Certificate of Completion by: STEVE HEDRICK date 6/24/94

Operation Permit by: date

HEALTH DEPT. COPY: WHITE INSPECTION COPY (FINAL): GREEN OWNER COPY (FINAL): YELLOW INSPECTION COPY (INITIAL): PINK OWNER COPY (INITIAL): GOLD