IREDELL COUNTY HEALTH DEPARTMENT

STATESVILLE 704-878-5305 MOORESVILLE 704-664-5281

IMPROVEMENT PERMIT / CERTIFICATE OF COMPLETION / OPERATION PERMIT / EXISTING SYSTEM INSPECTION

PROPERTY DESCRIPTION NO. REPAIR DATE 1/13/95 TAX MAP NO. Watershed: ☐ Yes ☐ No

OWNER OR CONTRACTOR SCOTT GOODMAN PHONE: Business Home 876-9611

ADDRESS RT 5 BOX 1063 STATESVILLE NC 28677

LOCATION 4.5 ± NC 115 N TR FRIENDSHIP RD, 1ST HOUSE ON (R) PAST N. CHIPLEY FORD ROAD

SUBDIVISION BLOCK / SECTION LOT LOT AREA AMPLE SITE CLASS P3 DESIGN FLOW 360 L.T.A.R. EXISTING

Septic Tank: EXISTING Gallons: STB Date

~~Pump Tank:~~ 750 GAL WASHER BOX Gallons: PT Date

Pump Make: Model Serial No.

Nitrification Field: No Fields 1 Square Feet 690 Linear Feet 230

No Lines 2 Trench Width 36" Max Trench Bottom Depth 18-36" Gravel Depth 12"

☐ New System ☑ Repair System Type: I, II, III, IV, V, VI

System Description: CONVENTIONAL GRAVITY

Repair System Description: CONV. GRAVITY

Maintenance Agreement Required: ☐ Yes ☑ No

☑ House/Mod. Home No. Bedrooms 3

☐ Mobile Home No. Bathrooms 1

☐ Business No. Employees

☐ Other


☐ Slab ☑ Crawl Space ☐ Basement w/plumbing ☐ Basement wo/plumbing

Water Supply: ☑ Individual ☐ Community ☐ Public WELL

Comments: ① PUMP-OUT SEPTIC TANK, REPLACE SANITARY TEE IF NECESSARY ② INSTALL NEW DIST. BOX AT LOCATION SHOWN ③ INSTALL NEW WASHER BOX AS SHOWN, ④ INSTALL NEW DROP BOX AS SHOWN

Comments: TANK PUMPED 1/28/95

INITIAL SITE SKETCH

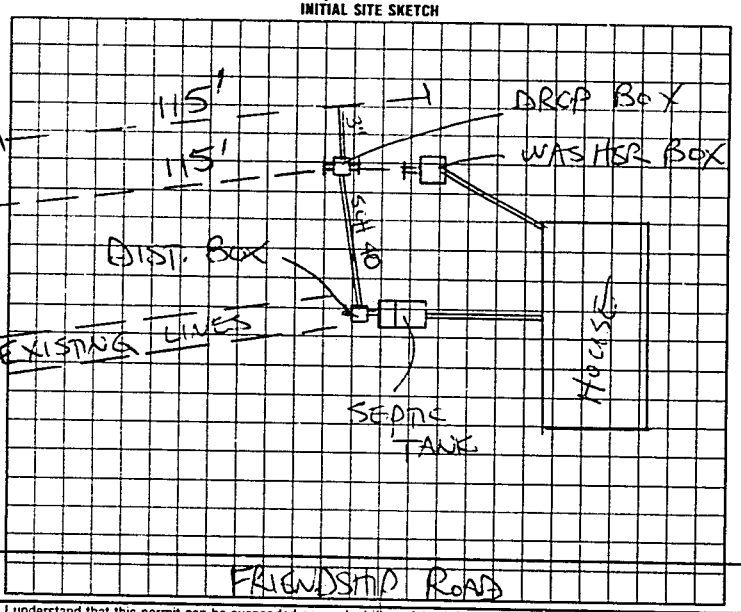

AS BUILT SKETCH

SYSTEM REPAIRED ACCORDING TO INITIAL SITE SKETCH

I understand that this permit can be suspended or revoked if any false information is supplied toward securing the permit/any unauthorized changes are made to the site/any unauthorized changes are made in the installation of the system. Improvement Permit is valid for 60 months from date of issuance.

Signed:

Improvement Permit by: STEVE HEDRICK date 1/13/95

Existing System Inspection by: date

Installed by: A-1 BACKHOE

Certificate of Completion by: STEVE HEDRICK date 1/28/95

Operation Permit by: date

HEALTH DEPT. COPY: WHITE INSPECTION COPY (FINAL): GREEN OWNER COPY (FINAL): YELLOW INSPECTION COPY (INITIAL): PINK OWNER COPY (INITIAL): GOLD