IREDELL COUNTY HEALTH DEPARTMENT

STATESVILLE 704-878-5305 (X) (01) MOORESVILLE 704-664-5281

IMPROVEMENT PERMIT / AUTHORIZATION TO CONSTRUCT / OPERATION PERMIT / EXISTING SYSTEM INSPECTION

PERMIT# 128143 PIN# 4830-54-1171 (31443 DATE 6-30-05

OWNER OR CONTRACTOR BUSY B FARMS, INC PHONE: Business (704) 902-3230 Home

ADDRESS 114 IVEY OAK RD, STATESVILLE, NC 28677

LOCATION I-77N TL TOMLIN MILL RD TL JENNINGS TR FRIENDSHIP TL BESS PROPERTY ON LEFT

SUBDIVISION BLOCK / SECTION LOT LOT AREA 41.526 SITE CLASS. PS DESIGN FLOW 360 L.T.A.R. 0.30 GPD/FT²

Septic Tank: 1000 Gallons; STB 1012 Date 11-14-04

Pump Tank: Gallons; PT Date

Pump Make: Model Serial No.

Nitrification Field: No. Fields 1 Square Feet 1200 Linear Feet 400

No Lines FOUR(4) Trench Width 36" Max Trench Bottom Depth 24" Gravel Depth 12"

☑ New System ☐ Repair System Type: I, (II), III, IV, V, VI

System Description: CONVENTIONAL GRAVITY

Repair System Description: GRAVITY 25% REDUCTION

Maintenance Agreement Required: ☐ Yes ☑ No

☑ House/Mod. Home No. Bedrooms 3

☐ Mobile Home No. Bathrooms

☐ Business No. Employees

☐ Other

☐ Slab ☐ Crawl Space ☑ Basement w/plumbing ☐ Basement wo/plumbing

Water Supply: ☑ Individual ☐ Public ☐ Community

Comments:/Conditions: ① INSTALL LINES ON CONTOUR ② MAINTAIN ALL SETBACKS ③ AN ACCEPTED SYSTEM MAY ALSO BE USED.

Comments:/Conditions:

Yellow flags like Septic Locations

INITIAL SITE SKETCH


* SCALE 1" = 100'

780'

DRIVE

BESS ROAD

AS BUILT SKETCH

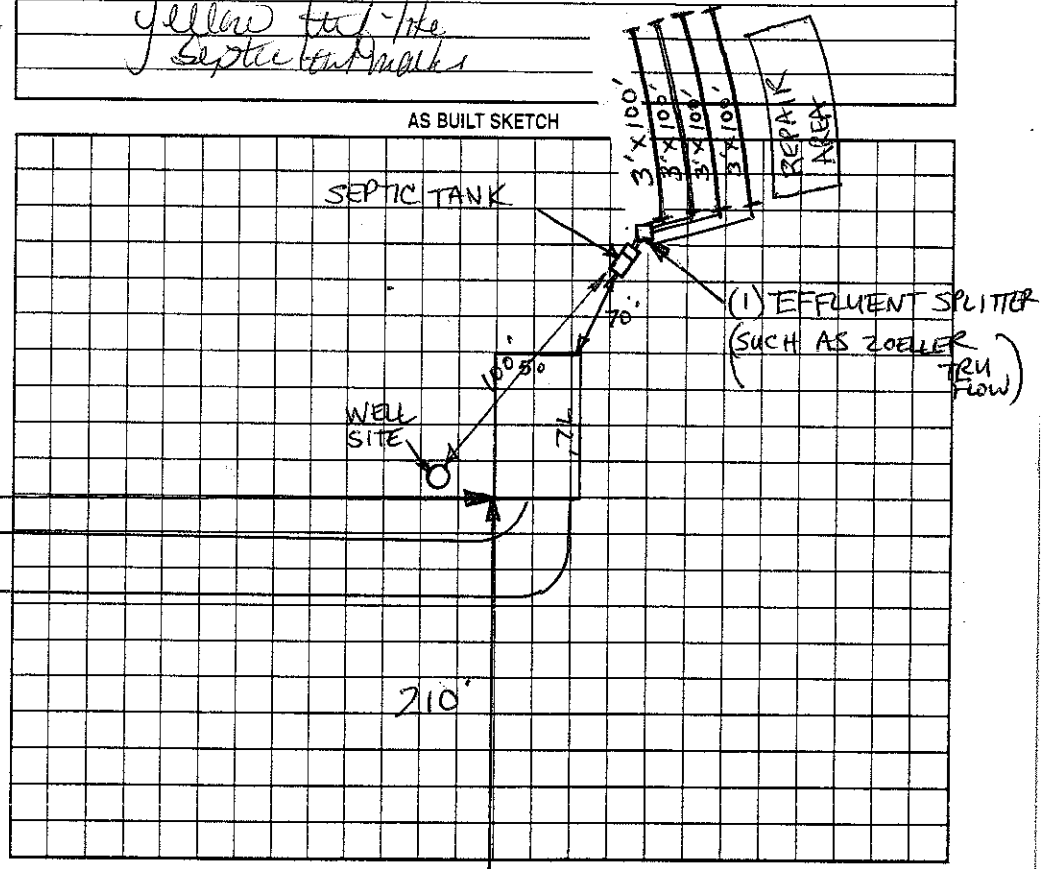

Permit can be suspended or revoked if any false information is supplied toward securing the permit/any unauthorized changes are made to the site/any unauthorized changes are made in the installation of the system. Improvement Permit with plat valid without expiration. Improvement Permit with site plan valid for sixty months. Authorization to Construct is valid for a period equal to that of Improvement Permit – not to exceed sixty months.

Signed: Dave Scott date 7-7-05 Installed by: Steve Jordan

Improvement Permit by: Christopher M. Sherrill RS, LSS date 6-30-05 Operation Permit by: Kelly Cook date 11-13-07

Authorization to Construct by: Christopher M Sherrill RS, LSS date 6-30-05 Existing System Inspection by: date

HEALTH DEPT. COPY: WHITE OWNER COPY (FINAL): YELLOW OWNER COPY (INITIAL): PINK