IREDELL COUNTY HEALTH DEPARTMENT

STATESVILLE 704-878-5305 MOORESVILLE 704-664-5281

IMPROVEMENT PERMIT / AUTHORIZATION TO CONSTRUCT / OPERATION PERMIT / EXISTING SYSTEM INSPECTION

PERMIT# 91990 PIN# 4830 631957 DATE 9/25/00

OWNER OR CONTRACTOR Donald R Branton PHONE: Business _____ Home 876-4710

ADDRESS 452 Bess Rd Statesville NC 28625

LOCATION Jennings, L Friendship, L Bess, 4th home on Lt.

SUBDIVISION — BLOCK / SECTION — LOT — LOT AREA — SITE CLASS PS DESIGN FLOW 240 L.T.A.R. 0.3

Septic Tank: 1000 Gallons; STB ~~600~~ Date _____

Pump Tank: _____ Gallons; PT _____ Date _____

Pump Make: _____ Model _____ Serial No. _____

Nitrification Field: No Fields 1 Square Feet 810 Linear Feet 270

No Lines 3 Trench Width 36" Max Trench Bottom Depth 36" Gravel Depth 12"

[X] New System [ ] Repair System Type: I (II) III IV V VI

System Description: Grav. Conv.

Repair System Description: Same

Maintenance Agreement Required: [ ] Yes [X] No

[ ] House/Mod. Home No. Bedrooms 2

[X] Mobile Home No. Bathrooms 1

[ ] Business No. Employees _____

[ ] Other _____


[ ] Slab [X] Crawl Space [ ] Basement w/plumbing [ ] Basement wo/plumbing

Water Supply: [X] Individual [ ] Public [ ] Community

Comments:/Conditions:

Comments:/Conditions

INITIAL SITE SKETCH

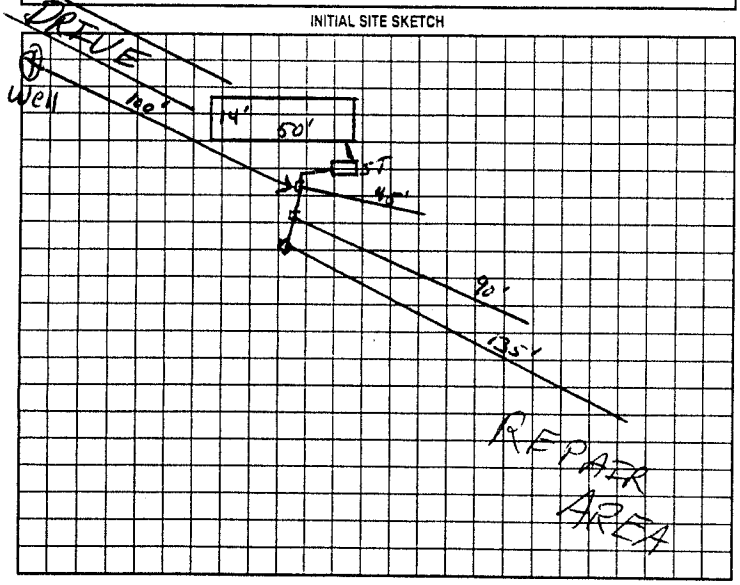

AS BUILT SKETCH

Permit can be suspended or revoked if any false information is supplied toward securing the permit/any unauthorized changes are made to the site/any unauthorized changes are made in the installation of the system. Improvement Permit with plat valid without expiration. Improvement Permit with site plan valid for sixty months. Authorization to Construct is valid for a period equal to that of Improvement Permit – not to exceed sixty months.

Signed: Donald R. Branton date _____

Improvement Permit by: RSI date 9/25/00

Authorization to Construct by: RSI date 9/25/00

Installed by: Kenny D...

Operation Permit by: Mark C. Offerman date 9-28-00

Existing System Inspection by: _____ date _____

HEALTH DEPT. COPY: WHITE OWNER COPY (FINAL): YELLOW OWNER COPY (INITIAL): PINK