IREDELL COUNTY HEALTH DEPARTMENT - *ENVIRONMENTAL HEALTH* ☑ STATESVILLE OFFICE 704-878-5305 ☐ MOORESVILLE OFFICE 704-664-5281

IMPROVEMENT PERMIT / AUTHORIZATION TO CONSTRUCT / OPERATION PERMIT / EXISTING SYSTEM INSPECTION

PERMIT # 174295 174295 PIN # 4830662869 DATE 8-23-12

OWNER Dean Denham APPLICANT: Same PHONE: Home/Cell # 704-876-9984 Business # N/A

SITE ADDRESS 979 Friendship Rd. OWNER / APPLICANT ADDRESS 1001 Friendship Rd. Statesville

SITE DIRECTIONS Jennings Rd. TL Friendship Rd. ; Property on left ~3miles

SUBDIVISION N/A BLOCK / SECTION N/A LOT # N/A LOT AREA 15.0 acres DESIGN FLOW 480 gpd L.T.A.R. 0.3

Septic Tank 1000 Gallons: STB 766-1000 Date 7-3

Pump Tank ____ Gallons: P T ____ Date ____

Pump Make ____ Model ____ Serial # ____

No. Nitrification Fields: 1 No. Lines 4 Linear Feet 536

Trench Width 36" Max. Trench Bottom Depth 36" Gravel Depth 12"

☑ New System ☐ Repair ☐ Expansion System Type I (II) III IV V Vi

System Description: Conventional - gravity

Repair System Description: Conventional - gravity

Maintenance Agreement Required ☐ YES ☑ NO

☑ GRAVITY ☐ PRESSURE

☑ Residence No. Bedrooms 4

☐ Business No. Persons ____

☐ Other No. Employees ____

☐ Slab ☐ Crawl Space


☑ Basement w/plumbing ☐ Basement w/o plumbing

Water Supply: ☐ Private ☑ Public ☐ Community


Comments / Conditions: Install a Conventional system on contour with serial distribution. An accepted system may also be installed.

★ - 25% Reduction system was installed ★

INITIAL SITE SKETCH

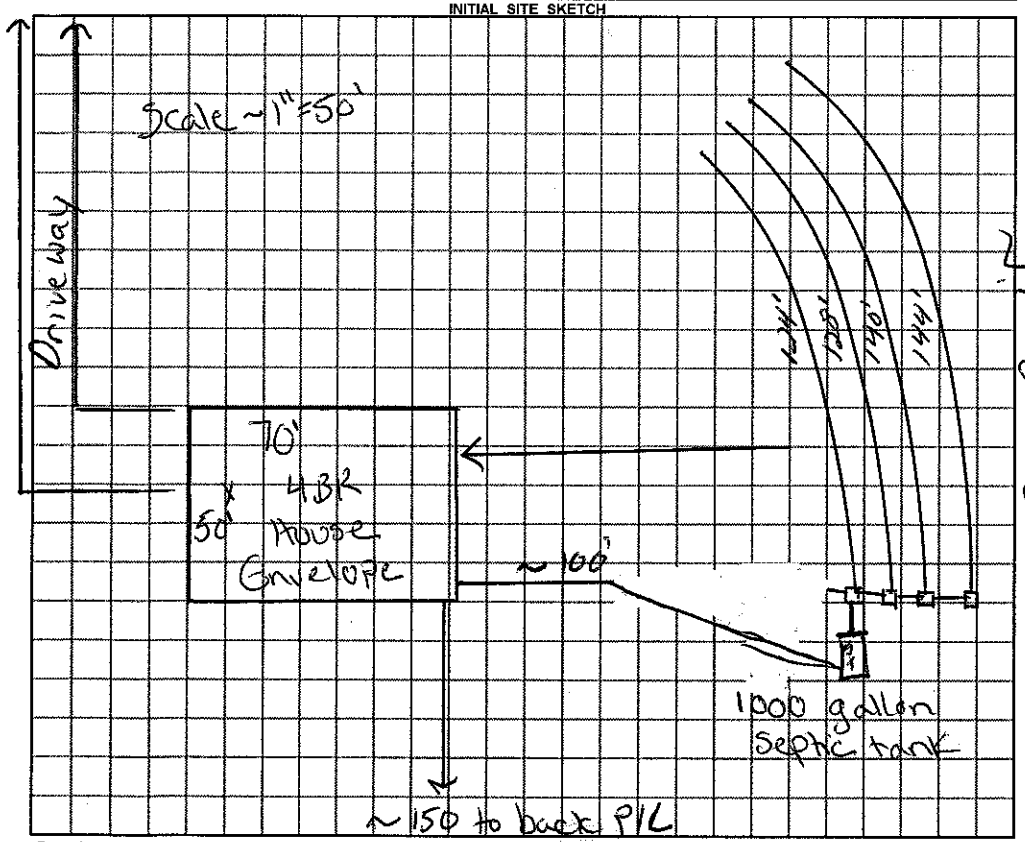

AS BUILT SKETCH

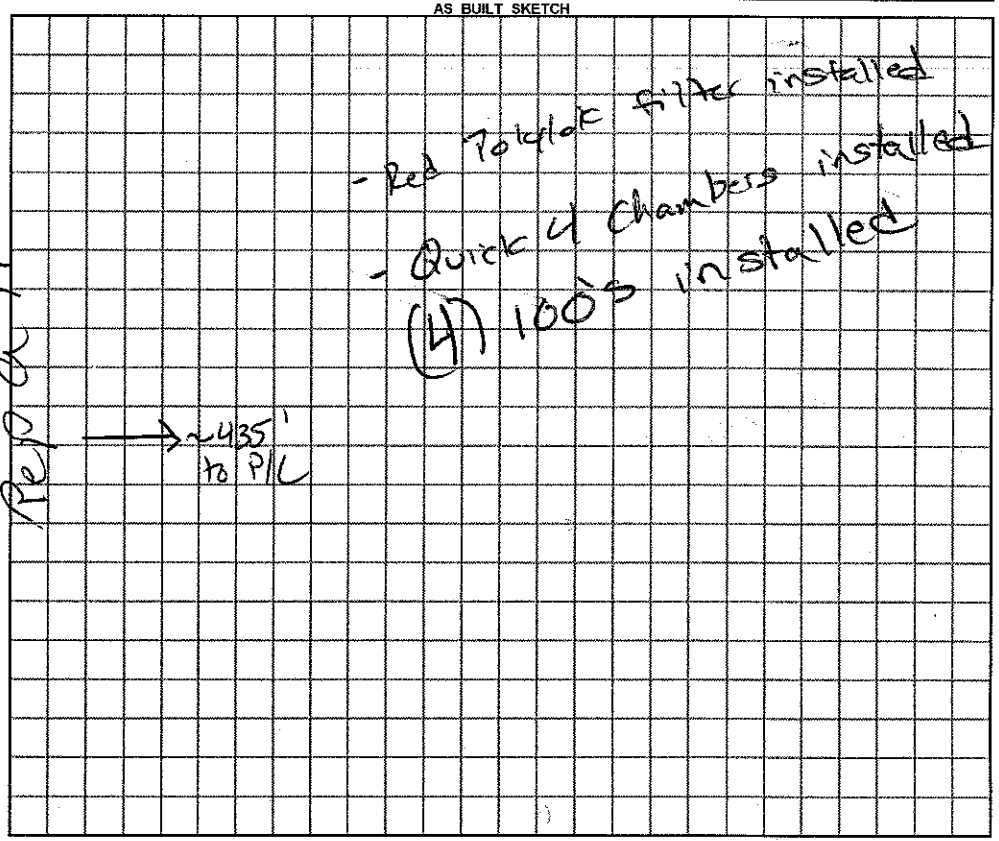

Permit can be suspended or revoked if any false information is supplied toward securing the permit / any unauthorized changes are made to the site / any unauthorized changes are made in the installation of the system.

☐ ***IMPROVEMENT PERMIT*** *with plat valid without expiration.* ☑ ***IMPROVEMENT PERMIT*** *with ~~plat valid without expiration.~~ site plan valid 60 mo.* ☑ ***AUTHORIZATION TO CONSTRUCT*** valid for period equal to IMPROVEMENT PERMIT--not to exceed 60 mo.

Owner / Applicant Signature: Lisa Denham Date 8-23-12 Installed by: Ground breakers

IMPROVEMENT PERMIT by: Justin Henderson REHS Date 8-23-12 OPERATION PERMIT by: Justin Henderson REHS Date 10-9-15

AUTHORIZATION TO CONSTRUCT by: Justin Henderson REHS Date 8-23-12 Existing System Inspected by: ____ REHS Date ____

YOU SHOULD CONTACT A LOCATOR SERVICE PRIOR TO ANY EXCAVATION

White Copy – Environmental Health YELLOW COPY (Final) Owner / Applicant PINK COPY (Initial) Owner / Applicant