IREDELL COUNTY HEALTH DEPARTMENT

Iville Phone TR 3-7271 Mooresville Phone NO 3-1271

PERMIT TO INSTALL SEPTIC TANK

Permit No. _____ Permit Date Feb 20 1965

Owner Friendship Methodist Ch. Address Statesville Rt 7

Installed By Roy Lentz Address Statesville


Location of Property Just Below church on Friendship Rd.

Tank		Capacity		Length of Lines		Fixtures	
Block	( )	1000	(✓)	225'	(✓)	No. of Baths	(1½)
Precast	( )	1250	( )	250'	( )	Dishwasher	( )
Poured		1500	( )	Other _____		Garbage Grdr.	( )
		Other _____				Other _____	

NOTIFY HEALTH DEPARTMENT AT LEAST EIGHT HOURS BEFORE TANK IS TO BE INSPECTED.

Final Inspection 2-20 1965 Approved (✓) Disapproved ( )

Remark Poured

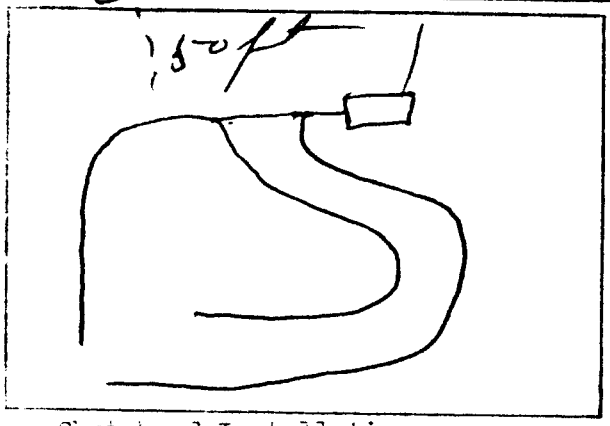

Sketch of Installation

R A

Sanitarian