IREDELL COUNTY HEALTH DEPARTMENT

STATESVILLE 704-878-5305 MOORESVILLE 704-664-5281

IMPROVEMENT PERMIT / AUTHORIZATION TO CONSTRUCT / OPERATION PERMIT / EXISTING SYSTEM INSPECTION

PERMIT# 165040 PIN# 4930-76-6479 DATE 3-2-11

OWNER OR APPLICANT Friendship UMC PHONE: Business 704 902 2105 Home

ADDRESS 907 Friendship Rd

LOCATION 21N onto Jennings, (L) on Friendship Church Rd, house on left before church.

SUBDIVISION n/a BLOCK / SECTION n/a LOT n/a LOT AREA 33 SITE CLASS. n/a DESIGN FLOW EX L.T.A.R. EX

Septic Tank: EX Gallons; STB Date

Pump Tank: Gallons; PT Date

Pump Make: Model Serial No.

Nitrification Field: No Fields EX Square Feet EX Linear Feet EX

No Lines EX Trench Width EX Max Trench Bottom Depth EX Gravel Depth EX ☒ Gravity ☐ Pressure

☐ New System ☐ Repair ☐ Expansion System Type: I (II) III IV V VI

System Description: Existing

Repair System Description:

Maintenance Agreement Required: ☐ Yes ☒ No

☒ House/Mod. Home No. Bedrooms EX

☐ Mobile Home No. Persons

☐ Business No. Employees

☐ Other


Water Supply: ☐ Individual ☒ Public ☐ Community

☐ Slab ☒ Crawl Space ☐ Basement w/plumbing ☐ Basement wo/plumbing

Comments:/Conditions:

Comments:/Conditions:

INITIAL SITE SKETCH

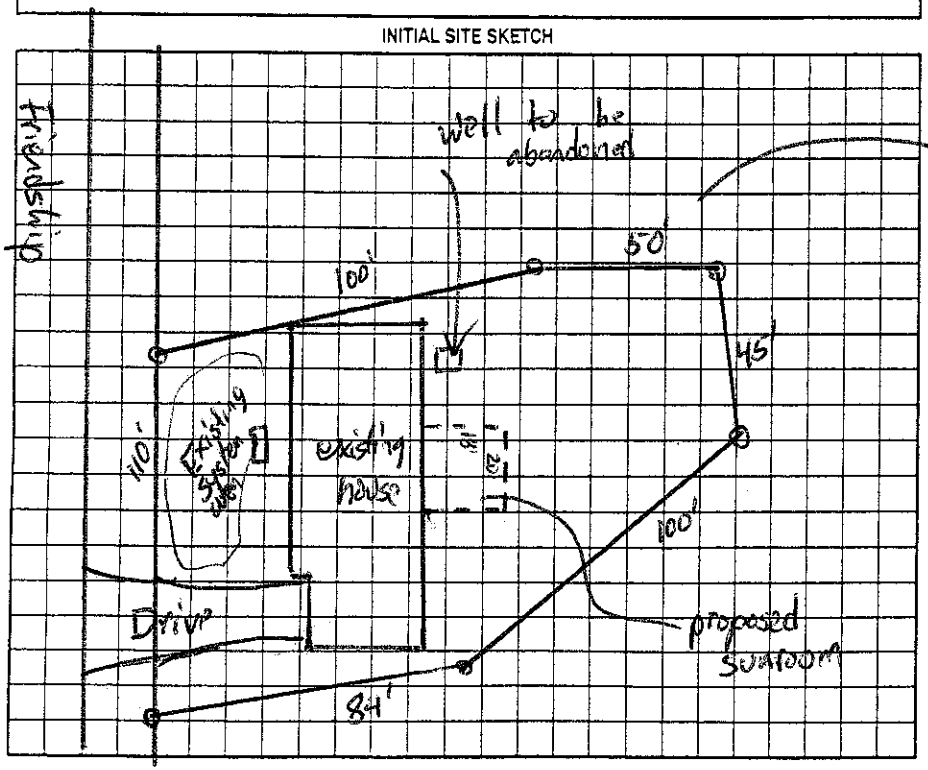

AS BUILT SKETCH

Permit can be suspended or revoked if any false information is supplied toward securing the permit/any unauthorized changes are made to the site/any unauthorized changes are made in the installation of the system. Improvement Permit with plat valid without expiration ☐ Improvement Permit with site plan valid for sixty months ☐ Authorization to Construct is valid for a period equal to that of Improvement Permit – not to exceed sixty months.

Signed: Edward Strassmeier date 3 2 2011 Installed by:

Improvement Permit by: date Operation Permit by: date

Authorization to Construct by: date Existing System Inspection by: James date 3-2-11

HEALTH DEPT. COPY: WHITE OWNER COPY (FINAL): YELLOW OWNER COPY (INITIAL): PINK