IREDELL COUNTY HEALTH DEPARTMENT

STATESVILLE 704-878-5305 (C1) MOORESVILLE 704-664-5281

(C) IMPROVEMENT PERMIT / AUTHORIZATION TO CONSTRUCT / OPERATION PERMIT / EXISTING SYSTEM INSPECTION

PERMIT# 104613 PIN# 4830-85-3581 DATE 2-12-02

OWNER OR CONTRACTOR FLEETWOOD HOMES PHONE: Business (704) 872-0179 Home

ADDRESS 1270 NORTHSIDE DRIVE, STATESVILLE NC 28625

LOCATION US 21 N, TL JENNINGS ROAD, TL FRIENDSHIP ROAD, ON LEFT ACROSS FROM GETHSEMANE ROAD

SUBDIVISION BLOCK / SECTION LOT LOT AREA 2.95 ACRES SITE CLASS. PS DESIGN FLOW 480 L.T.A.R. 0.30 GPD/FT

Septic Tank: 1000 Gallons; STB 794 Date 10-29-01
Pump Tank: Gallons; PT Date
Pump Make: Model Serial No.
Nitrification Field: No Fields 1 Square Feet 1600 Linear Feet 540
No Lines FOUR Trench Width 36" Max Trench Bottom Depth 36"

☒ New System ☐ Repair System Type: I II III IV V VI
System Description: CONVENTIONAL ERVTP
Repair System Description: CONV. ERVTP
Maintenance Agreement Required: ☐ Yes ☒ No
Gravel Depth 12" ☐ Slab ☒ Crawl Space ☐ Basement w/plumbing ☐ Basement wo/plumbing


☐ House/Mod. Home ☒ Mobile Home ☐ Business ☐ Other
No. Bedrooms 4 No. Bathrooms 2 No. Employees

Water Supply: ☐ Individual ☒ Public ☐ Community

Comments:/Conditions: PROP. LINE

Comments:/Conditions: SEPTIC TANK WITH MARKER INSTALLED USING "POLY LOK" FILTER

INITIAL SITE SKETCH ~SCALE: 1"=50'

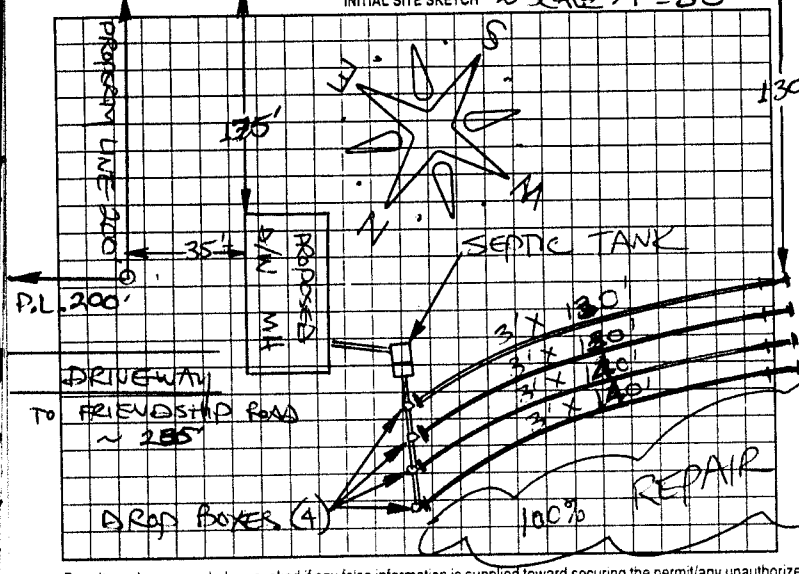

AS BUILT SKETCH

SYSTEM INSTALLED ACCORDING TO INITIAL SITE SKETCH

Permit can be suspended or revoked if any false information is supplied toward securing the permit/any unauthorized changes are made to the site/any unauthorized changes are made in the installation of the system. Improvement Permit with plat valid without expiration. Improvement Permit with site plan valid for sixty months. Authorization to Construct is valid for a period equal to that of Improvement Permit – not to exceed sixty months.

Signed: [signature] date 2-12-02 Installed by: H & S REPAIR

Improvement Permit by: STEVE HEDRICK date 2-12-02 Operation Permit by: STEVE HEDRICK date 3-7-02

Authorization to Construct by: STEVE HEDRICK date 2-12-02 Existing System Inspection by: date

HEALTH DEPT. COPY: WHITE OWNER COPY (FINAL): YELLOW OWNER COPY (INITIAL): PINK