IREDELL COUNTY HEALTH DEPARTMENT

STATESVILLE 704-878-5305 — MOORESVILLE 704-664-5281

IMPROVEMENT PERMIT / AUTHORIZATION TO CONSTRUCT / OPERATION PERMIT / EXISTING SYSTEM INSPECTION

PERMIT# 091745 PIN# 4839941698

OWNER OR CONTRACTOR Allen Tayes PHONE: Business 876-2183 Home DATE September 19, 2000

ADDRESS 310 Tom Road Statesville NC 28625

LOCATION 21 N. TL Jennings Rd TL Friendship Church Rd. 2.7 miles on left

SUBDIVISION AB Shaver BLOCK / SECTION LOT 1 LOT AREA 1.29Ac. SITE CLASS. AS DESIGN FLOW 360gpd L.T.A.R. .25-.3

Septic Tank: 1000 Gallons; STB 620 Date 8-8-00

Pump Tank: Gallons; PT Date

Pump Make: Model Serial No.

Nitrification Field: No Fields Square Feet 1200 Linear Feet 400

No Lines 4 Trench Width 36" Max Trench Bottom Depth 36"

☑ New System ☐ Repair System Type: I, II, III, IV, V, VI

System Description: Gravity conventional

Repair System Description: GRAV/pumped conventional

Maintenance Agreement Required: ☐ Yes ☑ No

Gravel Depth 12"

☐ Slab ☑ Crawl Space ☐ Basement w/plumbing ☐ Basement wo/plumbing

☑ House/Mod. Home No. Bedrooms 3

☐ Mobile Home No. Bathrooms 2

☐ Business No. Employees


☐ Other

Water Supply: ☐ Individual ☑ Public ☐ Community

Comments:/Conditions:

1" ≈ 60'

INITIAL SITE SKETCH

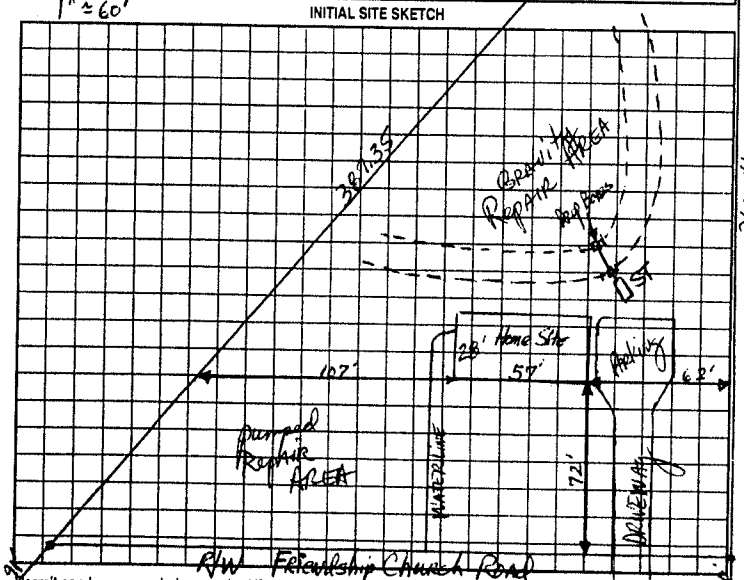

Comments:/Conditions:

Installed as shown

AS BUILT SKETCH

Permit can be suspended or revoked if any false information is supplied toward securing the permit/any unauthorized changes are made to the site/any unauthorized changes are made in the installation of the system. Improvement Permit with plat valid without expiration. Improvement Permit with site plan valid for sixty months. Authorization to Construct is valid for a period equal to that of Improvement Permit – not to exceed sixty months.

Signed: Allen J. Tayes date 9-20-00

Improvement Permit by: DR Jr, RS date 9-19-00

Authorization to Construct by: DR Jr, RS date 9-19-00

Installed by: Kenny Madison

Operation Permit by: Mark Cox RS date 9-28-00

Existing System Inspection by: date

HEALTH DEPT. COPY: WHITE OWNER COPY (FINAL) YELLOW OWNER COPY (INITIAL): PINK