IREDELL COUNTY HEALTH DEPARTMENT

STATESVILLE 704-878-5305 MOORESVILLE 704-664-5281

IMPROVEMENT PERMIT / AUTHORIZATION TO CONSTRUCT / OPERATION PERMIT / EXISTING SYSTEM INSPECTION

PERMIT# REPAIR PIN# 4830-94-7077 DATE 2-11-08

OWNER OR APPLICANT DAVID R. DRUM PHONE: Business 704-880-7006 Home 704-876-3073

ADDRESS 755 FRIENDSHIP ROAD, STATESVILLE NC 28625-9527

LOCATION JENNINGS ROAD TO FRIENDSHIP ROAD 2.6 MILES ON LEFT AT BOX #755

SUBDIVISION _____ BLOCK / SECTION _____ LOT _____ LOT AREA 1.0 ACRE SITE CLASS. PS DESIGN FLOW 240 L.T.A.R. 0.30 GPD/FT²

NEW

Septic Tank: 1000 Gallons: STB 494 Date 11-29-07

Pump Tank: _____ Gallons: PT _____ Date _____

Pump Make: _____ Model _____ Serial No. _____

Nitrification Field: No Fields 1 Square Feet EQUIV 800 Linear Feet 200

No Lines THREE Trench Width 36" Max Trench Bottom Depth 36" Gravel Depth N/A

☐ New System ☑ Repair ☐ Expansion System Type: I II (III) IV V VI

System Description: _____

Repair System Description: 25% REDUCTION GRAVITY

Maintenance Agreement Required: ☐ Yes ☑ No

☑ House/Mod. Home No. Bedrooms 2

☐ Mobile Home No. Persons ____

☐ Business No. Employees ____

☐ Other _____


Water Supply: ☑ Individual ☐ Public ☐ Community WELL

☑ Gravity ☐ Pressure ☐ Slab ☑ Crawl Space ☐ Basement w/plumbing ☐ Basement wo/plumbing

Comments:/Conditions: INSTALL 25% REDUCTION SYSTEM ON CONTOUR AS SHOWN

Comments:/Conditions: SEPTIC TANK W/ MARKER INSTALLED USING RED "POLYLOK" FILTER

INITIAL SITE SKETCH

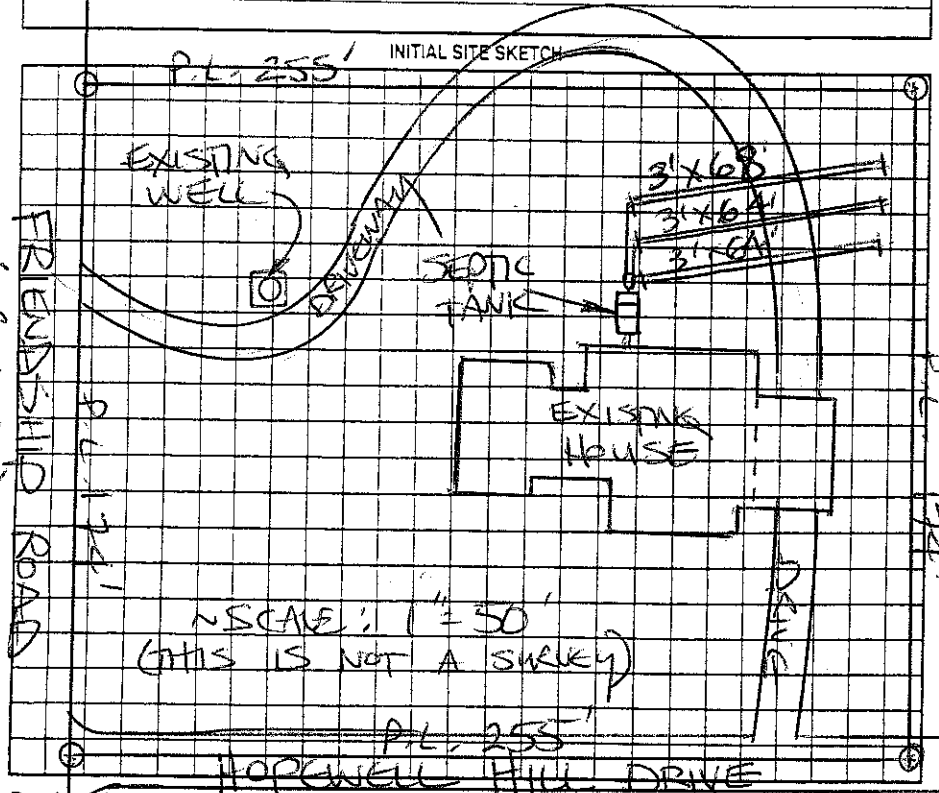

AS BUILT SKETCH

SYSTEM INSTALLED ACCORDING TO INITIAL SITE SKETCH

Permit can be suspended or revoked if any false information is supplied toward securing the permit/any unauthorized changes are made to the site/any unauthorized changes are made in the installation of the system. Improvement Permit with plat valid without expiration ☐ Improvement Permit with site plan valid for sixty months ☑ Authorization to Construct is valid for a period equal to that of Improvement Permit – not to exceed sixty months.

Signed: X _____ date 11/26/08 Installed by: A-1 BACKHOE

Improvement Permit by: STEVE HENDRICK date 2-11-08 Operation Permit by: STEVE HENDRICK date 2-12-08

Authorization to Construct by: STEVE HENDRICK date 2-11-08 Existing System Inspection by: _____ date _____

HEALTH DEPT. COPY: WHITE OWNER COPY (FINAL): YELLOW OWNER COPY (INITIAL): PINK