IREDELL COUNTY HEALTH DEPARTMENT

STATESVILLE 704-878-5305 CI MOORESVILLE 704-664-5281

IMPROVEMENT PERMIT / AUTHORIZATION TO CONSTRUCT / OPERATION PERMIT / EXISTING SYSTEM INSPECTION

PERMIT# 114288 PIN# ~~4831-08-6568~~ 4831-19-2568 DATE 8-1-03

OWNER OR CONTRACTOR EMMETT HEAD PHONE: Business 704-876-2327 Home

ADDRESS 796 OLIN LOOP OLIN, NC 28660

LOCATION NC 115 N, TR SPRINKLE ROAD, ON RIGHT AT # ~~[illegible]~~ 203, 0.4 MILE BEFORE MYERS MILL ROAD

SUBDIVISION BLOCK / SECTION LOT LOT AREA 5+ ACRES SITE CLASS. PS DESIGN FLOW 360 L.T.A.R. 0.40 GPD/FT²

Septic Tank: 1000 Gallons; STB 794 Date 6-25-03
Pump Tank: Gallons; PT Date
Pump Make: Model Serial No.
Nitrification Field: No Fields 1 Square Feet 900 Linear Feet 300
No Lines THREE Trench Width 36" Max Trench Bottom Depth 36" Gravel Depth 12"

☑ New System ☐ Repair System Type: I, II, III, IV, V, VI
System Description: CONVENTIONAL, GRAVITY
Repair System Description: CONVENTIONAL, PUMP
Maintenance Agreement Required: ☐ Yes ☑ No


☑ House/Mod. Home No. Bedrooms 3
☐ Mobile Home No. Bathrooms 2
☐ Business No. Employees
☐ Other
☐ Slab ☑ Crawl Space ☐ Basement w/plumbing ☐ Basement wo/plumbing

Water Supply: ☑ Individual ☐ Public ☐ Community WELL


Comments:/Conditions: ① KEEP SYSTEM MINIMUM 100 FEET FROM WELL (15A NCAC 18A .1956(6)(j)) STREAM
② INSTALL SYSTEM ACCORDING TO 15A NCAC 18A .1956(5) - STEEP SLOPES

Comments:/Conditions: ZABEL FILTER & MARKER INSTALLED AS SHOWN

INITIAL SITE SKETCH

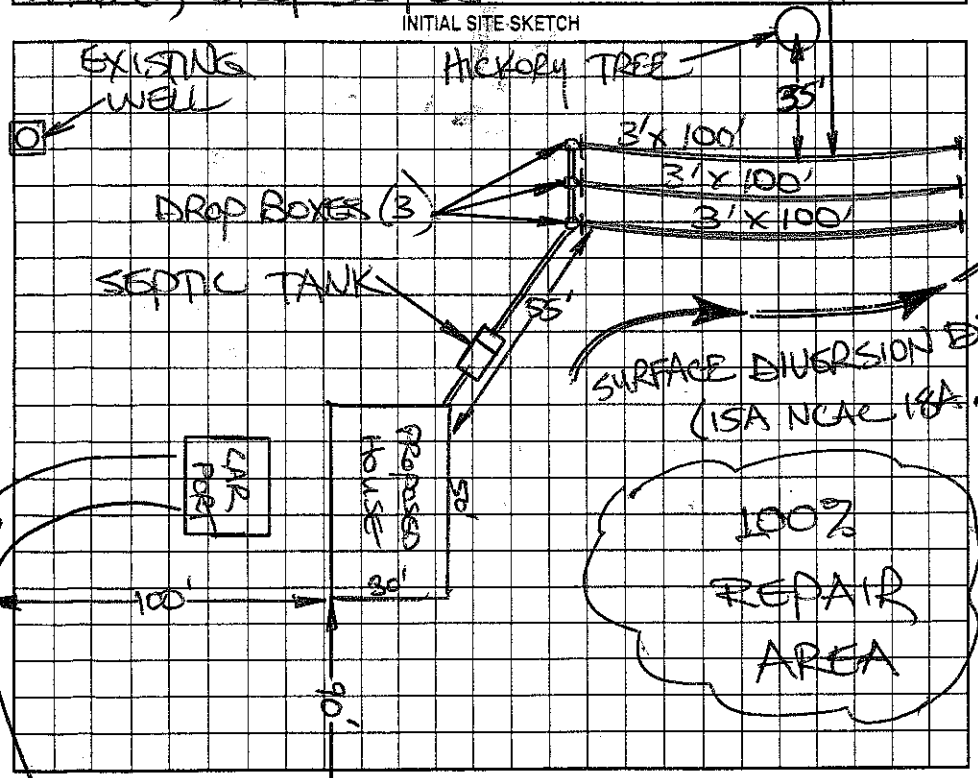

AS BUILT SKETCH

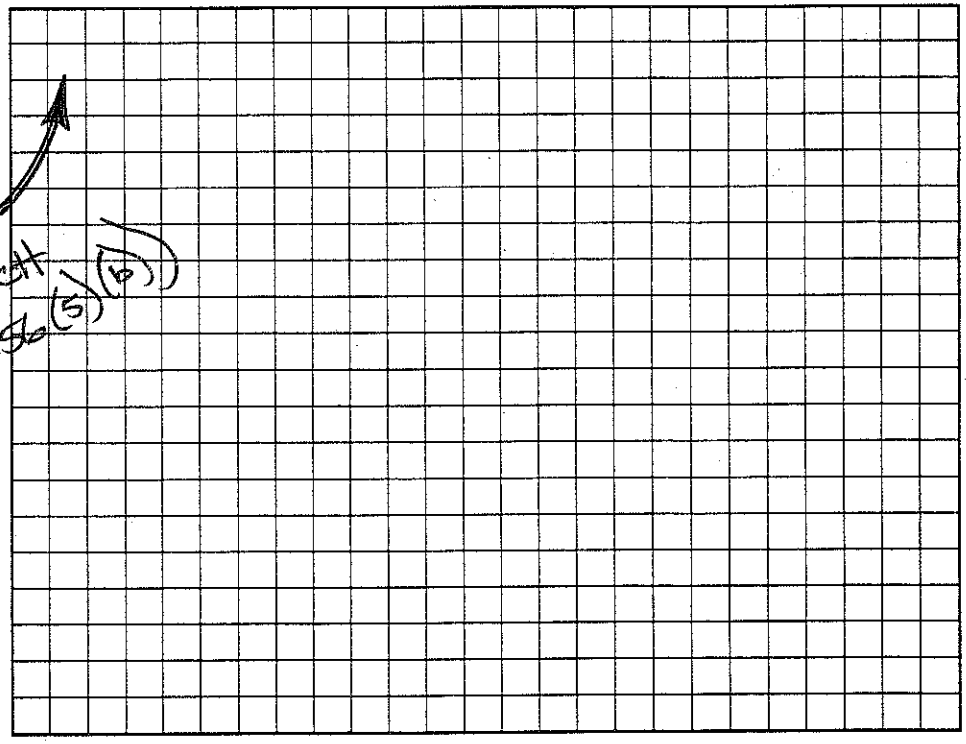

Permit can be suspended or revoked if any false information is supplied toward securing the permit/any unauthorized changes are made to the site/any unauthorized changes are made in the installation of the system. Improvement Permit with plat valid without expiration. Improvement Permit with site plan valid for sixty months. Authorization to Construct is valid for a period equal to that of Improvement Permit – not to exceed sixty months.

Signed: Emmett Head date 8-1-03 Installed by: ANDY DAVIS

Improvement Permit by: R-O-W STEVE HEARICK date 8-1-03 Operation Permit by: [signature] RS date 8-22-03

Authorization to Construct by: STEVE HEARICK date 8-1-03 Existing System Inspection by: date

HEALTH DEPT. COPY: WHITE OWNER COPY (FINAL): YELLOW OWNER COPY (INITIAL): PINK

SPRINKLE ROAD (SR 1868)