IREDELL COUNTY HEALTH DEPARTMENT

STATESVILLE 704-878-5305 MOORESVILLE 704-664-5281

IMPROVEMENT PERMIT / AUTHORIZATION TO CONSTRUCT / OPERATION PERMIT / EXISTING SYSTEM INSPECTION

PERMIT# 093526 PIN# 4831 08 6349 (PT) DATE 12-28-00

OWNER OR CONTRACTOR ANDREW PEARSON PHONE: Business Home 876-4437

ADDRESS 121 PRATT LANE, STATESVILLE, NC 28625

LOCATION NC 115 N, TR SPRINKLE ROAD 1.4 MILE ON LEFT

SUBDIVISION BLOCK / SECTION LOT LOT AREA ~1 ACRE SITE CLASS. PS DESIGN FLOW 360 L.T.A.R. 0.30 GPA/FT²

Septic Tank: 1000 Gallons: STB 1012 Date 8-26-01

Pump Tank: Gallons: PT Date

Pump Make: Model Serial No

Nitrification Field: No Fields 1 Square Feet 1200 Linear Feet 400

No Lines 3 1X Trench Width 36" Max Trench Bottom Depth 32" Gravel Depth 12"

☑ New System ☐ Repair System Type: I (II) III IV V VI

System Description: CONVENTIONAL GRAVITY

Repair System Description: CONVENTIONAL PUMP

Maintenance Agreement Required: ☐ Yes ☑ No

☐ Slab ☐ Crawl Space ☐ Basement w/plumbing ☑ Basement wo/plumbing

☐ House/Mod. Home No. Bedrooms 3

☐ Mobile Home No. Bathrooms 2


☐ Business No. Employees

☐ Other

Water Supply: ☐ Individual ☑ Public ☐ Community


Comments/Conditions: USE ONE FLOW DIVIDER TEE TO ACHIEVE EQUAL DISTRIBUTION INTO TWO SERIES OF DROP BOXES FEEDING THREE LINES.

SCALE: 1" = 50' INITIAL SITE SKETCH

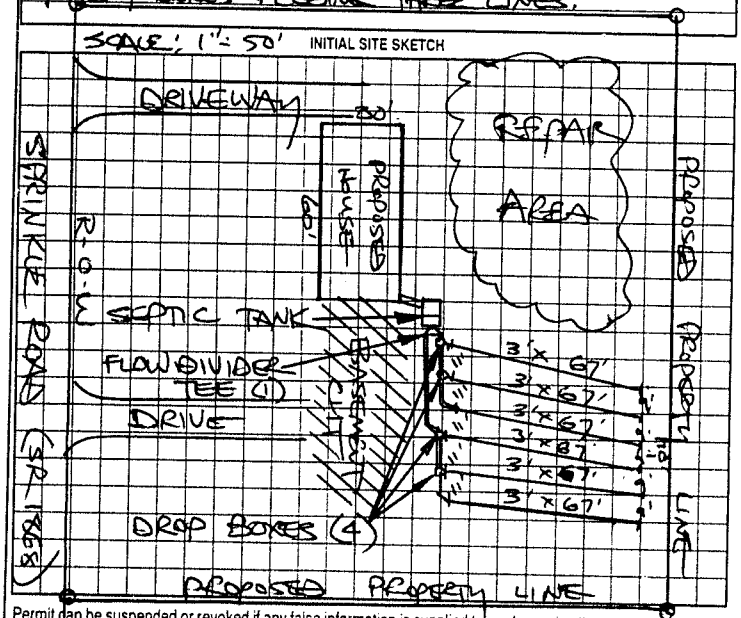

Comments/Conditions: ① SEPTIC TANK WITH MARKER INSTALLED USING "POLYLOK" FILTER ② SYSTEM INSTALLED AS PERMITTED, HOUSE MOVED DOWNSLOPE AS SHOWN

AS BUILT SKETCH

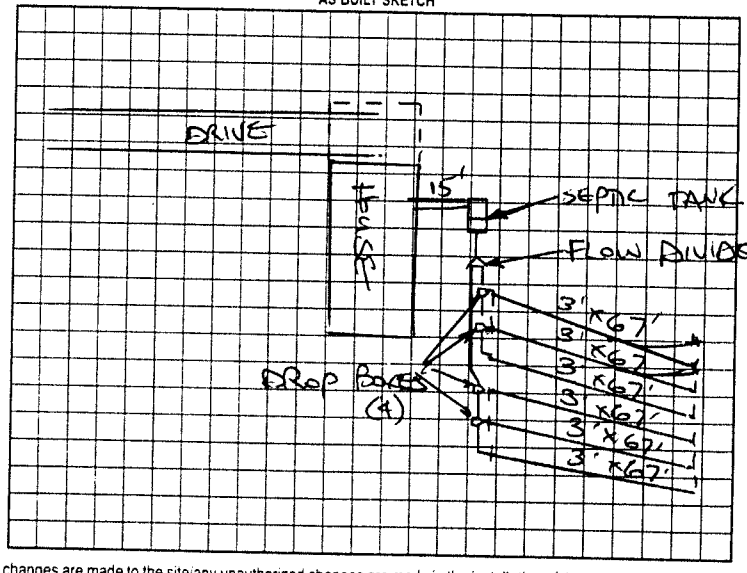

Permit can be suspended or revoked if any false information is supplied toward securing the permit/any unauthorized changes are made to the site/any unauthorized changes are made in the installation of the system. Improvement Permit with plat valid without expiration. Improvement Permit with site plan valid for sixty months. Authorization to Construct is valid for a period equal to that of Improvement Permit – not to exceed sixty months.

Signed: [signature] date 12/28/00 Installed by: STEVE JORDAN

Improvement Permit by: STEVE HEDRICK date 12-28-00 Operation Permit by: STEVE HEDRICK date 11-8-01

Authorization to Construct by: STEVE HEDRICK date 12-28-00 Existing System Inspection by: date

HEALTH DEPT. COPY WHITE OWNER COPY (FINAL) YELLOW OWNER COPY (INITIAL) PINK