IREDELL COUNTY HEALTH DEPARTMENT

STATESVILLE 704-878-5305 MOORESVILLE 704-664-5281

IMPROVEMENT PERMIT / CERTIFICATE OF COMPLETION / OPERATION PERMIT / EXISTING SYSTEM INSPECTION

PROPERTY DESCRIPTION NO. 070252 DATE 11-13-97 TAX MAP NO. 4831 29 6598 Watershed: ☐ Yes ☒ No

OWNER OR CONTRACTOR TIMOTHY COFFEY PHONE: Business Home 873-1028

ADDRESS 428 E. BARRIER ROAD STATESVILLE, NC 28677

LOCATION NC 115 N, TR SPRINKLE ROAD (SR 1868), GO 1.8 MILE, TR PRIVATE DRIVE AT BOX #131,

SUBDIVISION BLOCK / SECTION LOT LOT AREA 14.69 ACRES SITE CLASS. PS DESIGN FLOW 360 L.T.A.R. EXISTING

Septic Tank: 1000 Gallons; STB Date

Pump Tank: Gallons; PT Date

Pump Make: Model Serial No.

Nitrification Field: No Fields 1 Square Feet 750 Linear Feet 250

No Lines TWO Trench Width 36" Max Trench Bottom Depth DEEP Gravel Depth 10"

☐ New System ☐ Repair System Type: I, II, III, IV, V, VI

System Description: CONVENTIONAL GRAVITY

Repair System Description:

Maintenance Agreement Required: ☐ Yes ☒ No

☐ Slab ☐ Crawl Space ☐ Basement w/plumbing ☐ Basement wo/plumbing

☐ House/Mod. Home No. Bedrooms 3

☒ Mobile Home No. Bathrooms 2

☐ Business No. Employees

☐ Other


Water Supply: ☒ Individual ☐ Community ☐ Public

Comments:

Comments: * EXISTING HOUSE AND SINGLE WIDE MOBILE HOME TO BE REMOVED PRIOR TO OCCUPANCY OF D/W MH.

INITIAL SITE SKETCH

AS BUILT SKETCH

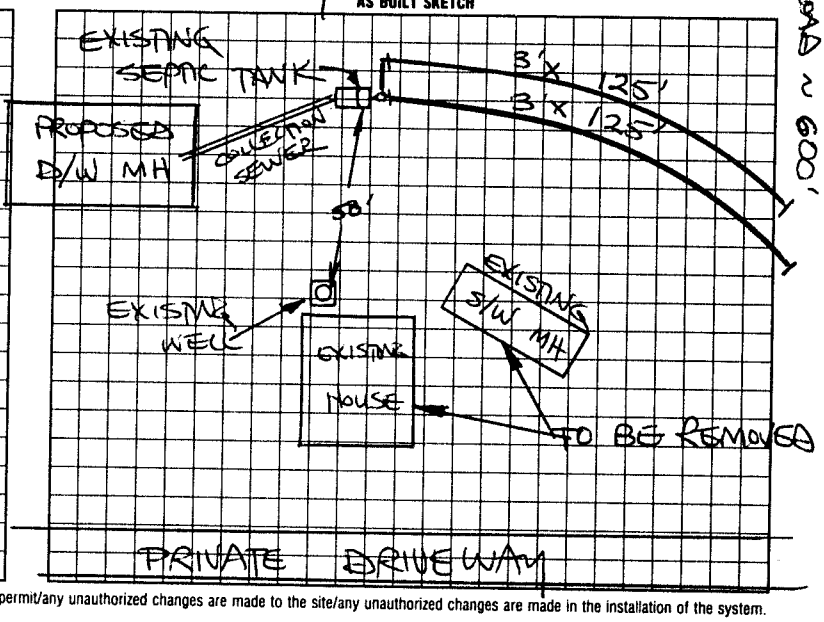

BACK OFF ROAD ± 600'

I understand that this permit can be suspended or revoked if any false information is supplied toward securing the permit/any unauthorized changes are made to the site/any unauthorized changes are made in the installation of the system. Improvement Permit is valid for 60 months from date of issuance.

Signed:

Improvement Permit by: date

Existing System Inspection by: STEVE HEDRICK date 11-13-97

Installed by:

Certificate of Completion by: date

Operation Permit by: date

HEALTH DEPT. COPY: WHITE INSPECTION COPY (FINAL): GREEN OWNER COPY (FINAL): YELLOW INSPECTION COPY (INITIAL): PINK OWNER COPY (INITIAL): GOLD