IREDELL COUNTY HEALTH DEPARTMENT (cad) STATESVILLE 704-878-5305 MOORESVILLE 704-664-5281

IMPROVEMENT PERMIT / AUTHORIZATION TO CONSTRUCT / OPERATION PERMIT / EXISTING SYSTEM INSPECTION

PERMIT # 154504 PIN # 4831336288 45 DATE 2-3-09

OWNER or APPLICANT Clayton Homes (Jessie R. Nicholson) PHONE: Business (704) 873-2547 Home:

OWNER or APPLICANT ADDRESS 2026 Northside Drive

LOCATION / DIRECTIONS Hwy 115 North, (R) on Friendship Rd, (L) on Myers Mill, lot on left

SUBDIVISION n/a BLOCK / SECTION LOT # n/a LOT AREA 10.6 DESIGN FLOW 480 L.T.A.R. .3

Septic Tank 1000 Gallons: STB Ex. Date Ex.

Pump Tank Gallons: P T Date

Pump Make Model Serial #

Nitrification Field No Fields 1 No Lines 1 (add) Linear Feet 100

Trench Width 36" Max. Trench Bottom Depth 36" Gravel Depth n/a ☒ GRAVITY ☐ PRESSURE

☐ New System ☐ Repair ☒ Expansion System Type I II III IV V VI

System Description: 25% Reduction System

Repair System Description: 25% Reduction System

Maintenance Agreement Required ☐ YES ☒ NO


☒ Residence No. Bedrooms 4 ☐ Business No. Persons ☐ Other No. Employees ☐ Slab ☒ Crawl Space ☐ Basement w/plumbing ☐ Basement w/o plumbing

Water Supply: ☒ Private ☐ Public ☐ Community

Comments / Conditions

Comments / Conditions

INITIAL SITE SKETCH

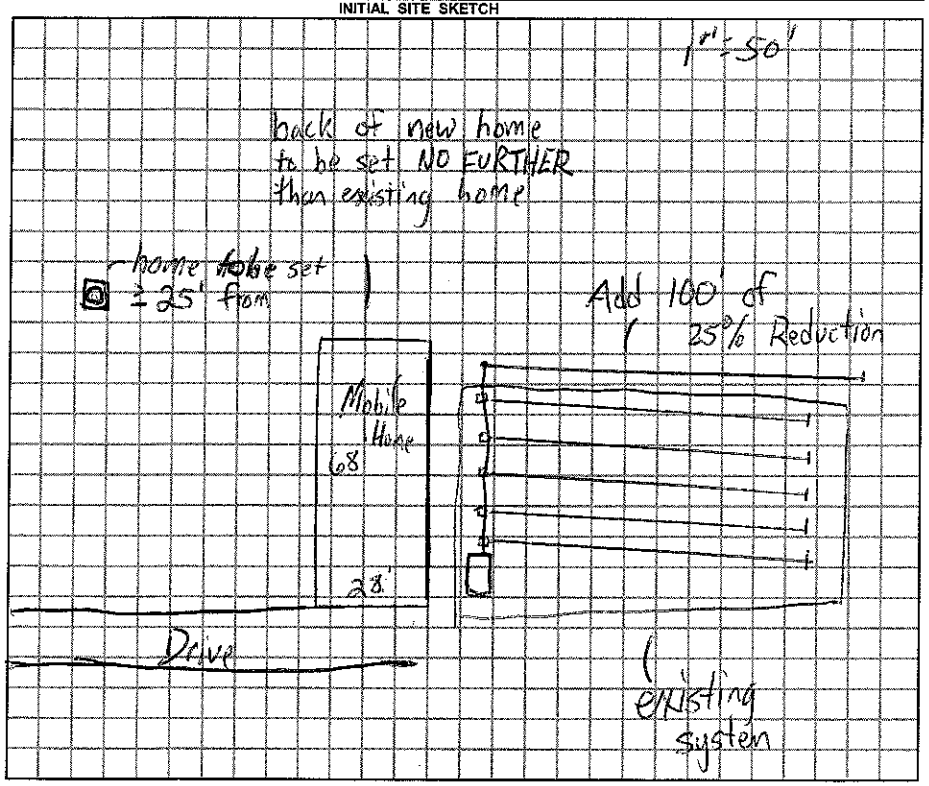

AS BUILT SKETCH

Permit can be suspended or revoked if any false information is supplied toward securing the permit / any unauthorized changes are made to the site / any unauthorized changes are made in the installation of the system.

☐ *IMPROVEMENT PERMIT w / plat valid without expiration* ☒ *IMPROVEMENT PERMIT w / site plan valid for 60 mos.* ☒ *AUTHORIZATION TO CONSTRUCT valid for period equal to IMPROVEMENT PERMIT-not to exceed 60 mo.*

Owner / Applicant Signature: Date 2-5-09

Improvement Permit by: Date 2-3-9

Authorzation to Construct by: Date 2-3-9

YOU SHOULD CONTACT A LOCATOR SERVICE PRIOR TO ANY EXCAVATION.

Installed by: Aheen Grading

Operation Permit by: Date: 5-1-09

Existing System Inspected by: Date:

WHITE COPY Environmental Health YELLOW COPY (Final) Owner / Applicant PINK COPY (Initial) Owner / Applicant