IREDELL COUNTY HEALTH DEPARTMENT

Statesville Office (704) 878-5305 Mooresville Office (704) 660-3625 PERMIT # 205247

IMPROVEMENT PERMIT / AUTHORIZATION TO CONSTRUCT / OPERATION PERMIT / EXISTING SYSTEM

PIN # 4831344653

APPLICANT: William Niblo

APPLICANT ADDRESS: 243 Myers Mill Rd.

SITE ADDRESS: 243 Myers Mill Rd.

PHONE: 704-592-4860 ALT. PHONE: N/A

SITE DIRECTIONS: Hwy 115 N TR Friendship TL Myers Mill Rd.

SUBDIVISION: N/A

SECTION: N/A LOT # N/A LOT AREA: 10.00 acres

DESIGN FLOW: 360 gpd L.T.A.R.: Existing

Septic Tank	Existing (gal)	STB	Date
Pump Tank	(gal)	PT	Date
Pump Make	Model		Serial #
# Nitrification Fields	1 # Lines	4	Linear Ft: Existing
Trench Width	Ex	Max. Trench Bottom Depth	Ex Gravel Depth Ex

☐ New System ☐ Repair ☐ Expansion System Type: I II (III) IV V VI

System Description: 25% Reduction

Repair System Description:

Maintenance Agreement Required: ☐ YES ☑ NO

☑ GRAVITY ☐ PRESSURE

☑ Residence No. Bedrooms 3

☐ Business No. Persons 6

☐ Other No. Employees

☐ Slab ☐ Crawl Space

☑ Basement w/plumbing ☐ Basement w/o plumbing


Water Supply: ☑ Private ☐ Public ☐ Community

Comments / Conditions:

- Maintain a minimum of 15' between basement foundation & all components of septic tank & site mi.

INITIAL SITE SKETCH

AS BUILT SKETCH

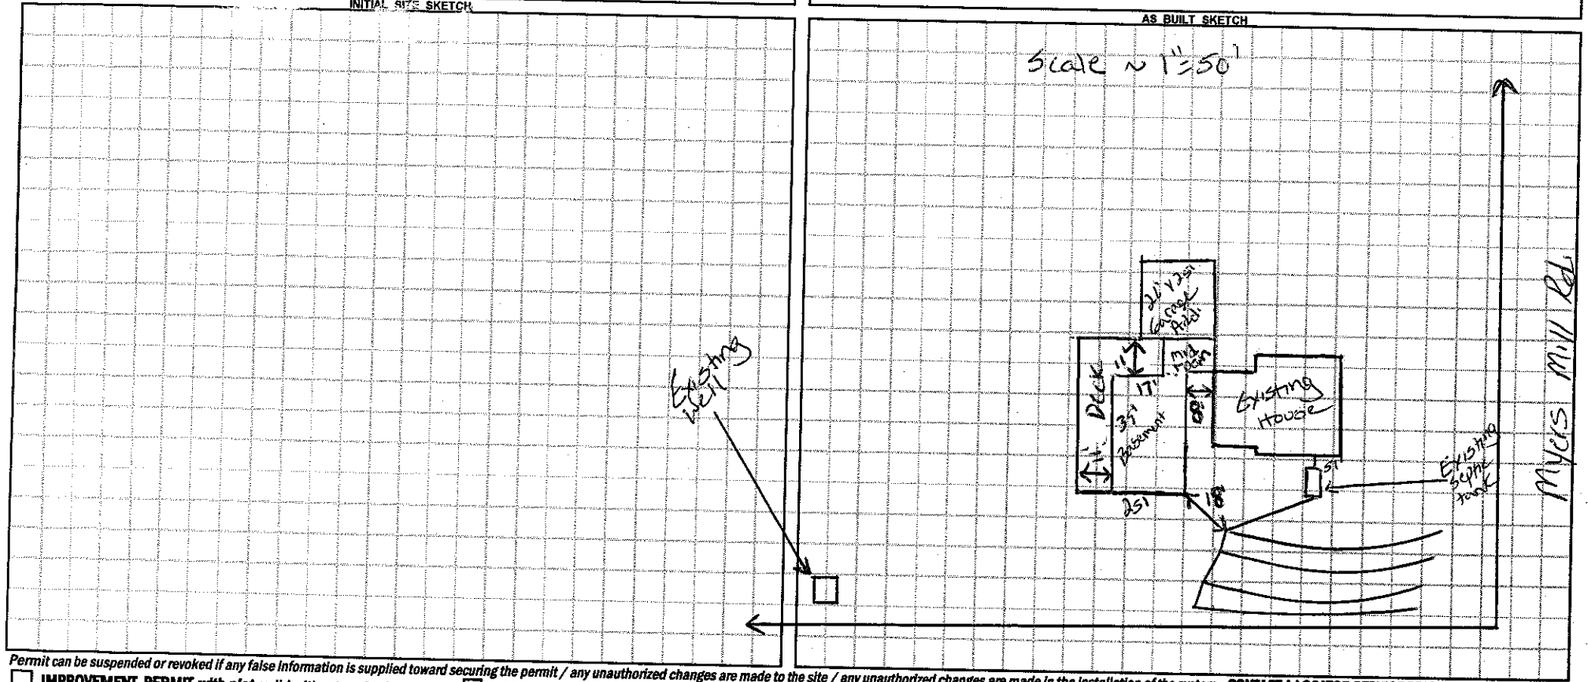

Permit can be suspended or revoked if any false information is supplied toward securing the permit / any unauthorized changes are made to the site / any unauthorized changes are made in the installation of the system. **CONTACT A LOCATOR SERVICE PRIOR TO ANY EXCAVATION**

☐ **IMPROVEMENT PERMIT** ***with plat*** *valid without expiration.* ☐ **IMPROVEMENT PERMIT** ***with site plan*** *valid for 60 mos.* ☐ **AUTHORIZATION TO CONSTRUCT** *valid for period equal to IMPROVEMENT PERMIT--not to exceed 60 mo.*

Owner / Applicant Signature: [signature] Date: 9/11/14

IMPROVEMENT PERMIT by: [signature] Date:

AUTHORIZATION TO CONSTRUCT by: Date:

Installed by:

OPERATION PERMIT by: Date:

Existing System Inspected by: [signature] Date: 9-6-14

Health Dept. Copy - WHITE Applicant (Final Approval) - YELLOW Applicant (Conditional Approval) - PINK