IREDELL COUNTY HEALTH DEPARTMENT - *ENVIRONMENTAL HEALTH* ☐ STATESVILLE OFFICE 704-878-5305 ☐ MOORESVILLE OFFICE 704-664-5281

IMPROVEMENT PERMIT / AUTHORIZATION TO CONSTRUCT / OPERATION PERMIT / EXISTING SYSTEM INSPECTION

PERMIT # REPAIR PIN # 4831-34-4653 DATE MAY 12, 2011

OWNER WILLIAM NIBLO APPLICANT: SAME PHONE: Home/Cell # 704-592-4860 Business #

SITE ADDRESS 243 MYERS MILL ROAD OWNER / APPLICANT ADDRESS 243 MYERS MILL ROAD, STATESVILLE

SITE DIRECTIONS FRIENDSHIP ROAD TO MYERS MILL ROAD, HOUSE ON LEFT AT BOX # 243

SUBDIVISION _____ BLOCK / SECTION _____ LOT # _____ LOT AREA 10.0 ACRES DESIGN FLOW 360 L.T.A.R. 0.30 GPD/FT2

Septic Tank EXISTING Gallons: STB _____ Date _____

Pump Tank _____ Gallons: P T _____ Date _____

Pump Make _____ Model _____ Serial # _____

No. Nitrification Fields: 1 No. Lines 4 Linear Feet 288

Trench Width 36" Max. Trench Bottom Depth 36" Gravel Depth N/A

☐ New System ☑ Repair ☐ Expansion System Type I II (III) IV V VI

System Description: _____

Repair System Description: 25% REDUCTION, GRAVITY

Maintenance Agreement Required ☐ YES ☑ NO

☑ GRAVITY ☐ PRESSURE

☑ Residence No. Bedrooms 3

☐ Business No. Persons _____

☐ Other No. Employees _____


☐ Slab ☐ Crawl Space

☐ Basement w/plumbing ☐ Basement w/o plumbing


Water Supply: ☑ Private WELL ☐ Public ☐ Community

Comments / Conditions (1) INSTALL 25% REDUCTION SYSTEM IN FOUR LINES ON CONTOUR AS SHOWN USING SERIAL DISTRIBUTION (2) CONSTRUCT DAM BETWEEN NEW LINES WHERE OLD LINE IS INTERSECTED.

INITIAL SITE SKETCH

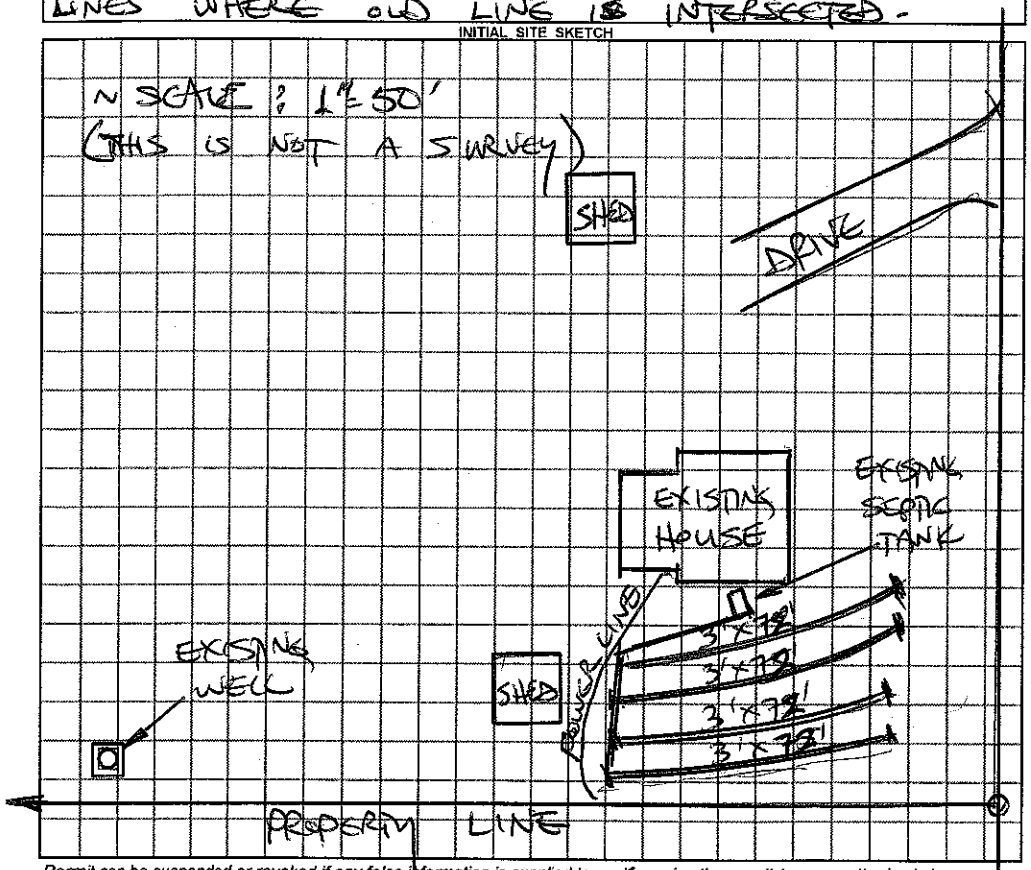

AS BUILT SKETCH

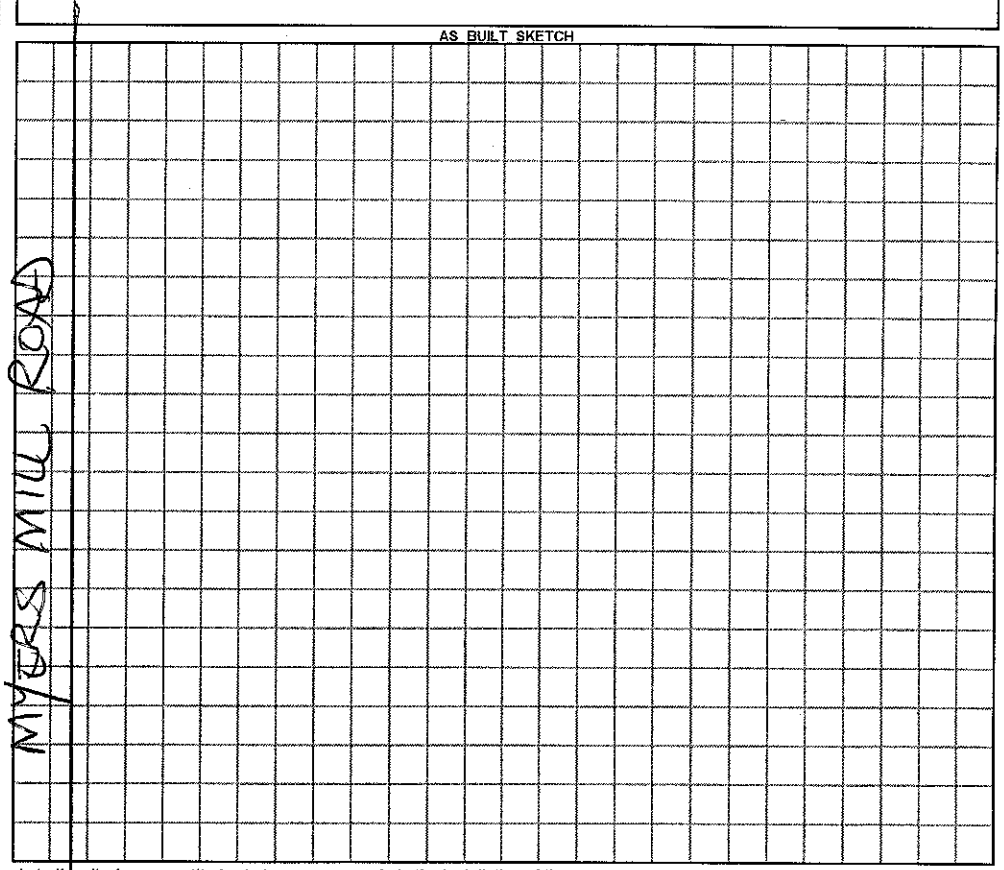

Permit can be suspended or revoked if any false information is supplied toward securing the permit / any unauthorized changes are made to the site / any unauthorized changes are made in the installation of the system.

☐ ***IMPROVEMENT PERMIT*** with plat valid without expiration. ☑ ***IMPROVEMENT PERMIT*** with plat valid without expiration. ☑ ***AUTHORIZATION TO CONSTRUCT*** valid for period equal to IMPROVEMENT PERMIT--not to exceed 60 mo.

Owner / Applicant Signature: _____ Date 5/12/11 Installed by: Dolly Madison

IMPROVEMENT PERMIT by: STEVE HEDRICK REHS Date 5-12-2011 OPERATION PERMIT by: _____ REHS Date 5-20-11

AUTHORIZATION TO CONSTRUCT by: STEVE HEDRICK REHS Date 5-12-2011 Existing System Inspected by: _____ REHS Date _____

YOU SHOULD CONTACT A LOCATOR SERVICE PRIOR TO ANY EXCAVATION

White Copy – Environmental Health YELLOW COPY (Final) Owner / Applicant PINK COPY (Initial) Owner / Applicant