IREDELL COUNTY HEALTH DEPARTMENT

STATESVILLE 704-878-5305 MOORESVILLE 704-664-5281

IMPROVEMENT PERMIT / AUTHORIZATION TO CONSTRUCT / OPERATION PERMIT / EXISTING SYSTEM INSPECTION

PERMIT# 086727 PIN# 4831 42 9228 (PART) DATE 12-20-99

OWNER OR CONTRACTOR BRIAN YORK PHONE: Business 592-9262 Home 539-5044

ADDRESS 255 TRUMPET BRANCH ROAD, OLIN, NC 28660

LOCATION NC 115 N, TR FRIENDSHIP RD, TL MYERS MILL RD, TR GRADY ROAD, 0.1 MILE ON LEFT

SUBDIVISION BLOCK / SECTION LOT LOT AREA 1.5 ACRE SITE CLASS PS DESIGN FLOW 360 L.T.A.R. 0.25 GPD/FT²

Septic Tank: 1000 Gallons; STB 1012 Date 1-16-00
Pump Tank: Gallons; PT Date
Pump Make: Model Serial No.
Nitrification Field: No Fields 1 Square Feet EQ. to 1440 Linear Feet 360±
No Lines FOUR Trench Width 36" Max Trench Bottom Depth 36" Gravel Depth SAND 6"

☑ New System ☐ Repair System Type: I, II, III, IV, V, VI
System Description: 25% REDUCTION GRAVITY
Repair System Description: 25% REDUCTION, PUMP
Maintenance Agreement Required: ☐ Yes ☑ No
☐ Slab ☐ Crawl Space ☑ Basement w/plumbing ☐ Basement wo/plumbing


☑ House/Mod. Home No. Bedrooms 3
☐ Mobile Home No. Bathrooms 2½
☐ Business No. Employees
☐ Other

Water Supply: ☑ Individual ☐ Public ☐ Community WELL


Comments/Conditions: ① KEEP SYSTEM MINIMUM 100 FEET FROM WELL ② INSTALL 25% REDUCTION SYSTEM USING SIXTY (60) CHAMBERS AT REQUIRED

Comments/Conditions: ① SEPTIC TANK RELOCATED DUE TO STUB-OUT & ROCK W/ PRIOR HEALTH DEPT. APPROVAL ② SEPTIC TANK W/ RISERS INSTALLED USING "POLYLOK" FILTER

INITIAL SITE SKETCH SCALE: 1"=50'

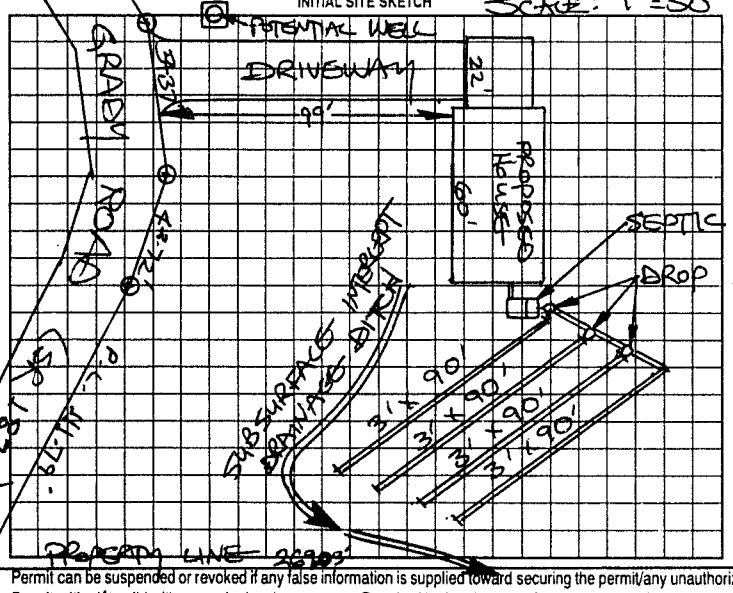

AS BUILT SKETCH

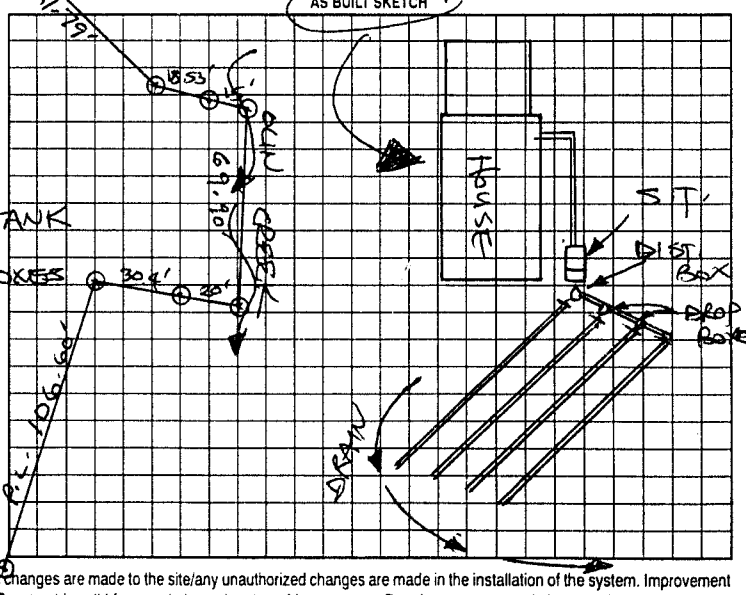

Permit can be suspended or revoked if any false information is supplied toward securing the permit/any unauthorized changes are made to the site/any unauthorized changes are made in the installation of the system. Improvement Permit with plat valid without expiration. Improvement Permit with site plan valid for sixty months. Authorization to Construct is valid for a period equal to that of Improvement Permit – not to exceed sixty months.

Signed: Irma H. York date 1/27/00 Installed by: #1 BACKHOE

Improvement Permit by: STEVE HEDRICK date 12-20-99 Operation Permit by: STEVE HEDRICK date 5-1-00

Authorization to Construct by: STEVE HEDRICK date 12-20-99 Existing System Inspection by: date

HEALTH DEPT. COPY: WHITE OWNER COPY (FINAL): YELLOW OWNER COPY (INITIAL): PINK