IREDELL COUNTY HEALTH DEPARTMENT

STATESVILLE 704-878-5305 MOORESVILLE 704-664-5281

IMPROVEMENT PERMIT / AUTHORIZATION TO CONSTRUCT / OPERATION PERMIT / EXISTING SYSTEM INSPECTION

PERMIT# REPAIR PIN#

OWNER OR CONTRACTOR REX & JESTENE TEMPLETON PHONE: Business Home (336) 838-1429 DATE 6-19-98

ADDRESS 219 GRADY ROAD STATESVILLE NC 28625

LOCATION NC 115 N, TR FRIENDSHIP ROAD, TL MYERS MILL ROAD, TR GRADY ROAD, 0.3 MILE ON RIGHT

SUBDIVISION BLOCK / SECTION LOT LOT AREA ACRE SITE CLASS PSI DESIGN FLOW 360 L.T.A.R. EXISTING

Septic Tank: EXISTING Gallons; STB 1012 Date 5-23-98
Pump Tank: Gallons; PT Date
Pump Make: Model Serial No.
Nitrification Field: No Fields 1 Square Feet 510 Linear Feet 170
No Lines TWO Trench Width 36" Max Trench Bottom Depth 36" Gravel Depth 12"

☐ New System ☑ Repair System Type: I II III IV V VI
System Description:
Repair System Description: CONVENTIONAL GRAVITY
Maintenance Agreement Required: ☐ Yes ☑ No


☑ House/Mod. Home No. Bedrooms
☐ Mobile Home No. Bathrooms
☐ Business No. Employees
☐ Other
☐ Slab ☑ Crawl Space ☐ Basement w/plumbing ☐ Basement wo/plumbing

Water Supply: ☑ Individual ☐ Public ☐ Community WELL


Comments:/Conditions: ① PUMP-OUT SEPTIC TANK AND INSPECT FOR WEIGHTY, REPLACE IF NECESSARY ② REPLACE SANITARY TEE IN EXISTING TANK IF NECESSARY

Comments:/Conditions: Note: Hit Rock first line Set New Tank

INITIAL SITE SKETCH SCALE: 1" = 40'

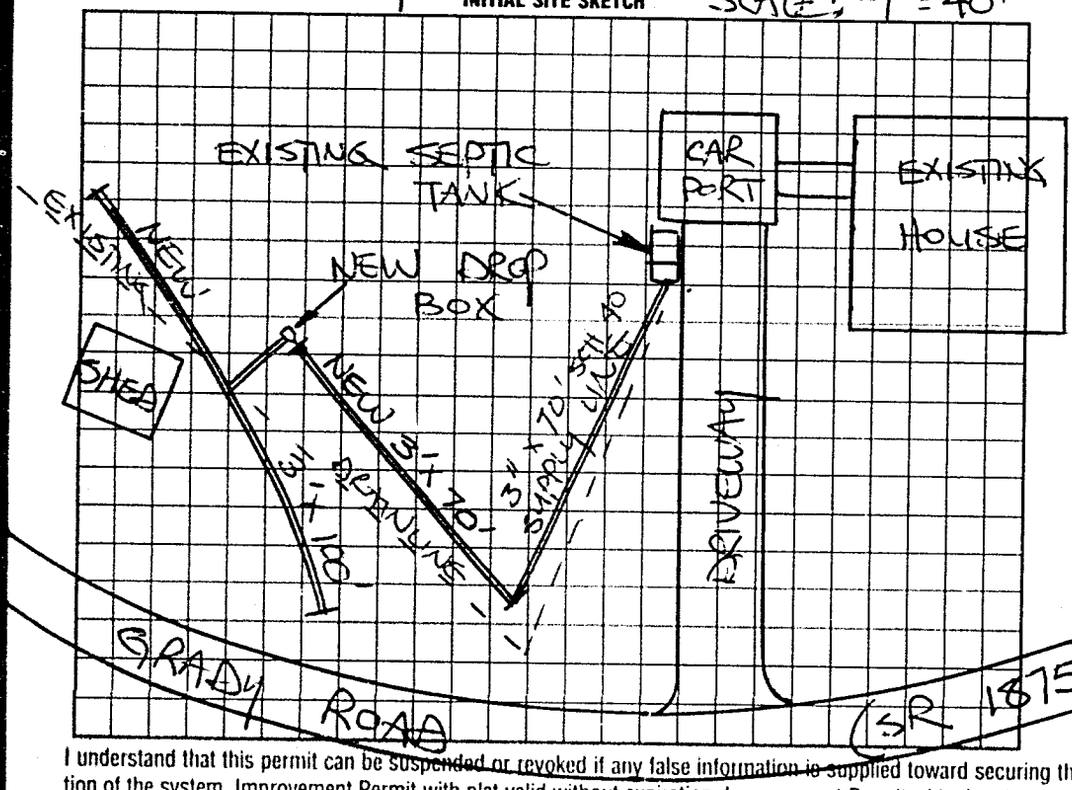

AS BUILT SKETCH

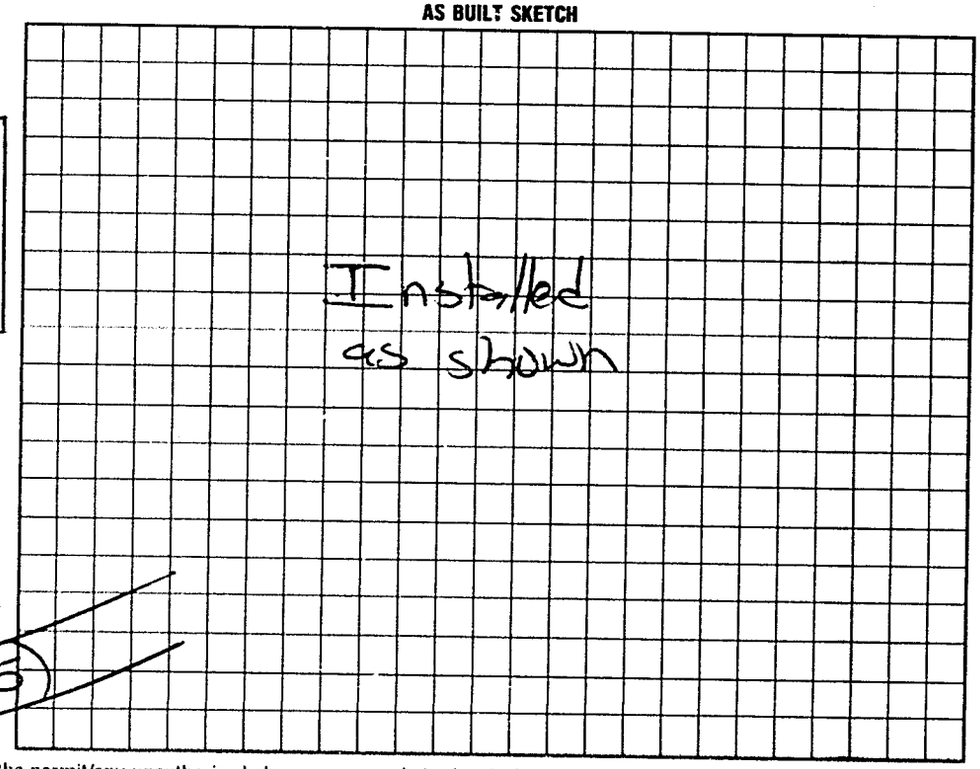

I understand that this permit can be suspended or revoked if any false information is supplied toward securing the permit/any unauthorized changes are made to the site/any unauthorized changes are made in the installation of the system. Improvement Permit with plat valid without expiration. Improvement Permit with site plan valid for sixty months. Authorization to Construct is valid for a period equal to that of Improvement Permit – not to exceed sixty months.

Signed: + Rex T. Templeton date 6/19/98 Installed by: Kenny Madison

Improvement Permit by: STEVE HENDRICK date 6-19-98 Operation Permit by: [illegible] date 7-21-98

Authorization to Construct by: STEVE HENDRICK date 6-19-98 Existing System Inspection by: date

HEALTH DEPT. COPY: WHITE INSPECTION COPY (FINAL): GREEN OWNER COPY (FINAL): YELLOW INSPECTION COPY (INITIAL): PINK OWNER COPY (INITIAL): GOLD