IREDELL COUNTY HEALTH DEPARTMENT

STATESVILLE 704-878-5305 MOORESVILLE 704-664-5281

IMPROVEMENT PERMIT / AUTHORIZATION TO CONSTRUCT / OPERATION PERMIT / EXISTING SYSTEM INSPECTION

PERMIT# 145889 Remodel # PIN# 4831710153 DATE 10-23-07

OWNER OR APPLICANT Corey Speece PHONE: Business Kutn-704929-0029 Home 704-539-5579

ADDRESS 241 Eupetic Springs RD Statesville NC 28625

LOCATION JENNINGS RD North (L) Friendship (R) Mt. Vernon (L) Eupetic Springs 1st House on Left BOX # 241

SUBDIVISION — BLOCK / SECTION — LOT — LOT AREA 0.394 AC SITE CLASS. 1S DESIGN FLOW 360 L.T.A.R.

Septic Tank: 1000 Gallons: STB 794 Date 4-24-07
Pump Tank: Gallons: PT Date
Pump Make: Model Serial No.
Nitrification Field: No Fields 1 Square Feet 600 Linear Feet 240'
No Lines 3 Trench Width 7½ x 80' Max Trench Bottom Depth — Gravel Depth 10"

☐ New System ☒ Repair ☐ Expansion System Type: I (II) III IV V VI
System Description: NEW TANK
Repair System Description:
Maintenance Agreement Required: ☐ Yes ☒ No

☒ House/Mod. Home No. Bedrooms 3
☐ Mobile Home No. Persons 2
☐ Business No. Employees
☐ Other


Water Supply: ☒ Individual ☐ Public ☐ Community

☒ Gravity ☐ Pressure ☐ Slab ☐ Crawl Space ☒ Basement w/plumbing ☐ Basement wo/plumbing

Comments:/Conditions: ① Install New TANK, OLD TANK COLLAPSED ② Existing Bed 7½ x 80 was probed & system was properly functioning & showed no signs of failure.

Comments:/Conditions: ③ This Permit serves as Notice of Violation and must be repaired within 30 DAYS. POLYLOK Filter & RISERS

INITIAL SITE SKETCH

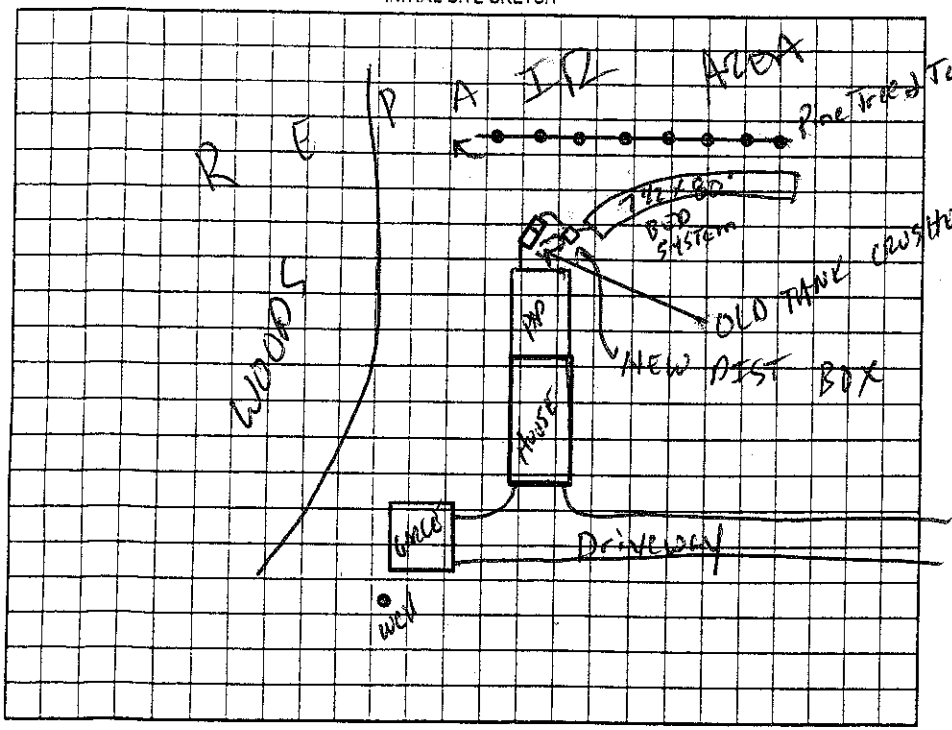

AS BUILT SKETCH

Permit can be suspended or revoked if any false information is supplied toward securing the permit/any unauthorized changes are made to the site/any unauthorized changes are made in the installation of the system. Improvement Permit with plat valid without expiration ☐ Improvement Permit with site plan valid for sixty months ☐ Authorization to Construct is valid for a period equal to that of Improvement Permit – not to exceed sixty months.

Signed: Corey A Speece date 10-23-07 Installed by: Darrell Beam

Improvement Permit by: [signature] date 10-23-07 Operation Permit by: [signature] date 10-25-07

Authorization to Construct by: [signature] date 10-23-07 Existing System Inspection by: date

HEALTH DEPT. COPY: WHITE OWNER COPY (FINAL): YELLOW OWNER COPY (INITIAL): PINK