David Barnes Construction 3:30

IREDELL COUNTY HEALTH DEPARTMENT

STATESVILLE 704-878-5305 MOORESVILLE 704-664-5281 59860

IMPROVEMENT PERMIT / CERTIFICATE OF COMPLETION / OPERATION PERMIT / EXISTING SYSTEM INSPECTION

PROPERTY DESCRIPTION NO. 23290 DATE 3-21-96 TAX MAP NO 16D-A-32 Watershed: Yes ~~No~~

OWNER OR CONTRACTOR C. R. JURNEY PHONE: Business Home 539-4569

ADDRESS 214 JURNEY RIDGE LANE, OLIN, NC 28660

LOCATION US 21 N, TL JENNINGS RD, TL EUREPTIC SPRINGS RD, TR JURNEY RIDGE LANE, NEAR END ON RIGHT

SUBDIVISION BLOCK / SECTION LOT LOT AREA 13.88 AC SITE CLASS PS DESIGN FLOW 360' L.T.A.R 0.33 GPD/FT²

Septic Tank 1000 Gallons; STB 1012 Date 1-26-96

Pump Tank Gallons; PT Date

Pump Make Model Serial No

Nitrification Field No Fields 1 Square Feet 1080 Linear Feet 360

No Lines 4 Trench Width 36" Max Trench Bottom Depth 18-28" Gravel Depth 12"

✓ New System Repair System Type I II III IV V

System Description: CONVENTIONAL GRAVITY

Repair System Description CONV. GRAVITY

Maintenance Agreement Required Yes No

House/Mod Home ✓ Mobile Home Business Other

No Bedrooms 3 No Bathrooms 2 No Employees


Slab ✓ Crawl Space Basement w/plumbing Basement w/o plumbing

Water Supply ✓ Individual Community Public SPRING

Comments: ① USE THREE FLOW DIVIDER TEES TO ACHIEVE EQUAL DISTRIBUTION INTO EACH OF FOUR LINES ② INSTALL LINES AS SHOWN, ON CONTOUR NO DEEPER THAN 28".

Comments:

INITIAL SITE SKETCH

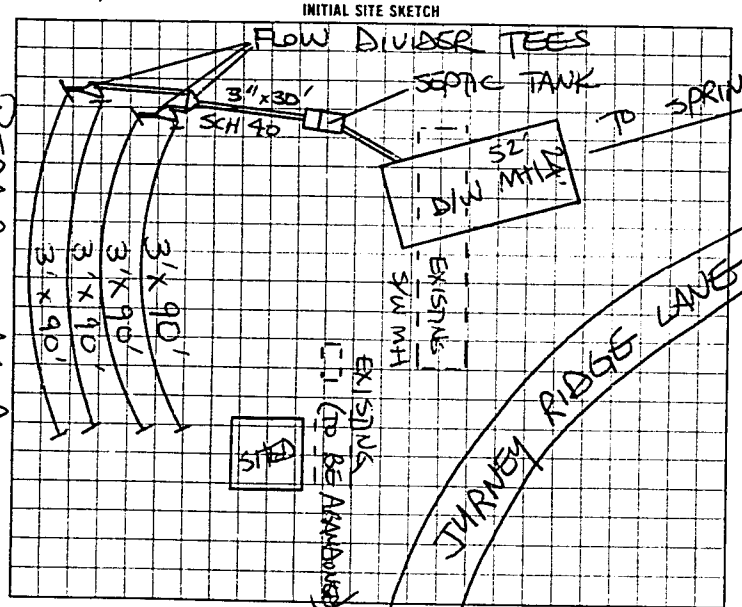

AS BUILT SKETCH

SYSTEM INSTALLED ACCORDING TO INITAL SITE SKETCH

I understand that this permit can be suspended or revoked if any false information is supplied toward securing the permit/any unauthorized changes are made to the site/any unauthorized changes are made in the installation of the system

AUTHORIZATION TO CONSTRUCT IS VALID FIVE (5) YEARS FROM DATE OF ISSUANCE. IMPROVEMENT PERMIT HAS NO EXPIRATION DATE.

Signed X C. R. Hall Installed by DAVID BARNES CONSTRUCTION

Improvement Permit by STEVE HENRICK date 3-21-96 Certificate of Completion by date

AUTHORIZATION TO CONSTRUCT

Existing System Inspection by STEVE HENRICK date 3-21-96 Operation Permit by STEVE HENRICK date 4-4-96

HEALTH DEPT COPY WHITE INSPECTION COPY (FINAL) GREEN OWNER COPY (FINAL) YELLOW INSPECTION COPY (INITIAL) PINK OWNER COPY (INITIAL)

15000