IREDELL COUNTY HEALTH DEPARTMENT

Statesville Office (704) 878-5305 Mooresville Office (704) 660-3625 PERMIT # 20143

IMPROVEMENT PERMIT / AUTHORIZATION TO CONSTRUCT / OPERATION PERMIT / EXISTING SYSTEM

PIN # 4831809913

APPLICANT: Edward Virtue APPLICANT ADDRESS: 494 Mt. Vernon Ch. Rd Olin NC 28660

SITE ADDRESS: 494 Mt Vernon Ch. Rd. PHONE: 704-450-0700 ALT. PHONE: 336-240-8290

SITE DIRECTIONS: 77N exit 59 (L) on Tomlin mill (L) on Jennings (R) on Friendship (R) on Mt Vernon Ch. Rd


SUBDIVISION: SECTION: N/A LOT # N/A LOT AREA: 10.4ac DESIGN FLOW: 240 L.T.A.R.: .25

Septic Tank	1000 (gal)	STB	760-1000	Date	11-27	☐ New System	☒ Repair	☐ Expansion	System Type: I (II) III IV V VI	☒ Residence	No. Bedrooms 2
Pump Tank	N/A (gal)	PT	N/A	Date	N/A	System Description:		N/A		☐ Business	No. Persons 4
Pump Make	N/A	Model		Serial #		Repair System Description:		25% Reduction		☐ Other	No. Employees
# Nitrification Fields	1	# Lines	2	Linear Ft:	240	Maintenance Agreement Required:	☐ YES	☒ NO		☐ Slab	☐ Crawl Space
Trench Width	36"	Max. Trench Bottom Depth	36"	Gravel Depth	N/A		☒ GRAVITY	☐ PRESSURE		☐ Basement w/plumbing	☒ Basement w/o plumbing

Water Supply: ☐ Private ☒ Public ☐ Community

Comments / Conditions: Check tank, check tee, replace if necessary. Maintain >50' off existing well.

INITIAL SITE SKETCH

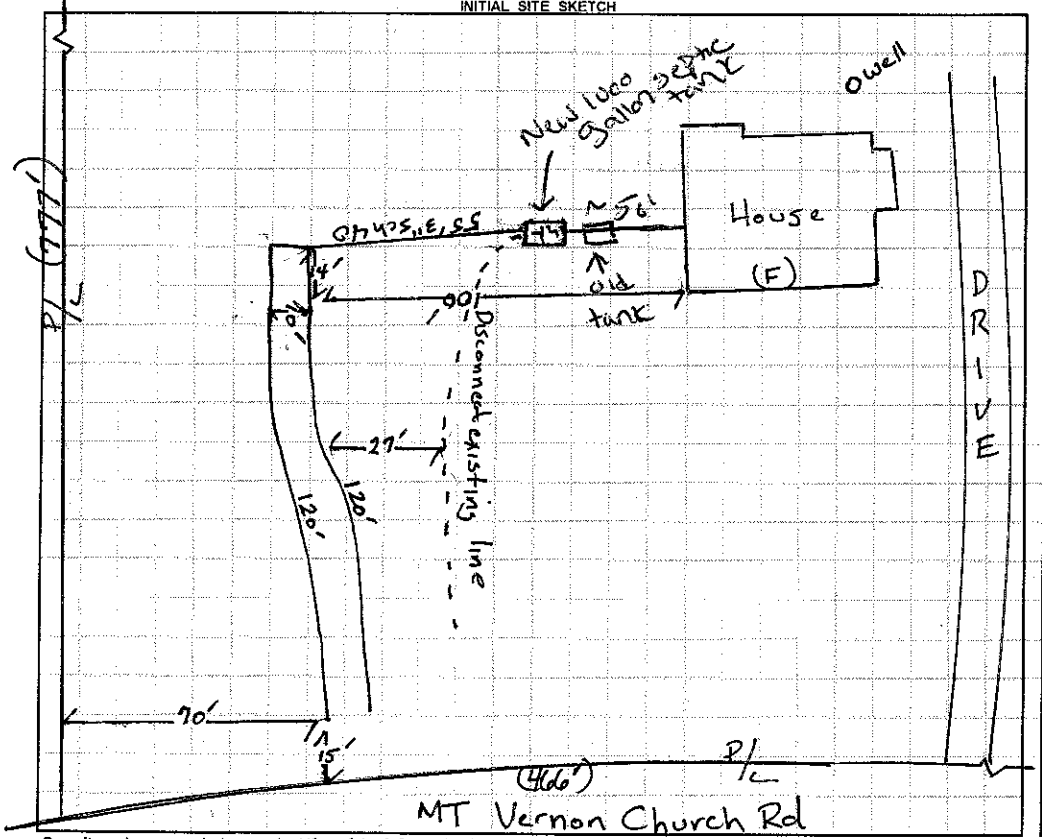

AS BUILT SKETCH

- Red Polylok Filter installed
- BIOFAB Chambers Installed
- Installed as drawn.

Permit can be suspended or revoked if any false information is supplied toward securing the permit / any unauthorized changes are made to the site / any unauthorized changes are made in the installation of the system. **CONTACT A LOCATOR SERVICE PRIOR TO ANY EXCAVATION**

☐ **IMPROVEMENT PERMIT** *with plat valid without expiration* ☒ **IMPROVEMENT PERMIT** *with site plan valid for 60 mos.* ☒ **AUTHORIZATION TO CONSTRUCT** *valid for period equal to IMPROVEMENT PERMIT--not to exceed 60 mo.*

Owner / Applicant Signature: Edward Virtue Date: 2/17/14 Installed by: Tim Abee

IMPROVEMENT PERMIT by: Robert H. Lee Date: 02/10/14 OPERATION PERMIT by: Justin Henderson Date: 3-27-14

AUTHORIZATION TO CONSTRUCT by: Robert H. Lee Date: 02/10/14 Existing System Inspected by: Date:

Health Dept. Copy - WHITE Applicant (Final Approval) - YELLOW Applicant (Conditional Approval) - PINK