IREDELL COUNTY HEALTH DEPARTMENT

CI

STATESVILLE 704-878-5305 MOORESVILLE 704-664-5281

IMPROVEMENT PERMIT / AUTHORIZATION TO CONSTRUCT / OPERATION PERMIT / EXISTING SYSTEM INSPECTION

PERMIT# 115318 PIN# 4831-84-6915 DATE 8/18/04

OWNER OR CONTRACTOR WILLIAM K. SEIGWORTH PHONE: Business Home (704) 539-4889

ADDRESS 437 EUPEPTIC SPRINGS RD. OLIN NC 28660 (#437)

LOCATION I-77N TL TOMLIN MILL RD TR JENNINGS TL MT. VERNON CH RD TR EUPEPTIC SPRS RD CROSS BRIDGE 2ND BOX ON LEFT 2

SUBDIVISION BLOCK / SECTION LOT LOT AREA 1.0 SITE CLASS. PS DESIGN FLOW 480 L.T.A.R. 0.3 gpd/ft

Septic Tank: 1000 EX. Gallons; STB Date
Pump Tank: Gallons; PT Date
Pump Make: Model Serial No.
Nitrification Field: No Fields 1 Square Feet Linear Feet 140'
No Lines 2 Trench Width 36" Max Trench Bottom Depth 36" Gravel Depth 12"

☑ New System ☐ Repair System Type: I (II) III, IV, V, VI
System Description: CON. GRAVITY
Repair System Description: SAME
Maintenance Agreement Required: ☐ Yes ☑ No

☑ House/Mod. Home No. Bedrooms 4
☐ Mobile Home No. Bathrooms 3
☐ Business No. Employees
☐ Other


☑ Slab ☐ Crawl Space ☐ Basement w/plumbing ☐ Basement wo/plumbing

Water Supply: ☑ Individual ☐ Public ☐ Community


Comments:/Conditions: (1) ADDING 1 BEDROOM 'GARAGE' ONTO EXISTING 3-BEDROOM SYSTEM, BRINGING TOTAL LINEAR FOOTAGE TO 540 LIN. FT. FOR WHOLE SYSTEM

Comments:/Conditions: ~~SAMMY~~ CREEK

INITIAL SITE SKETCH SCALE 1"=40'

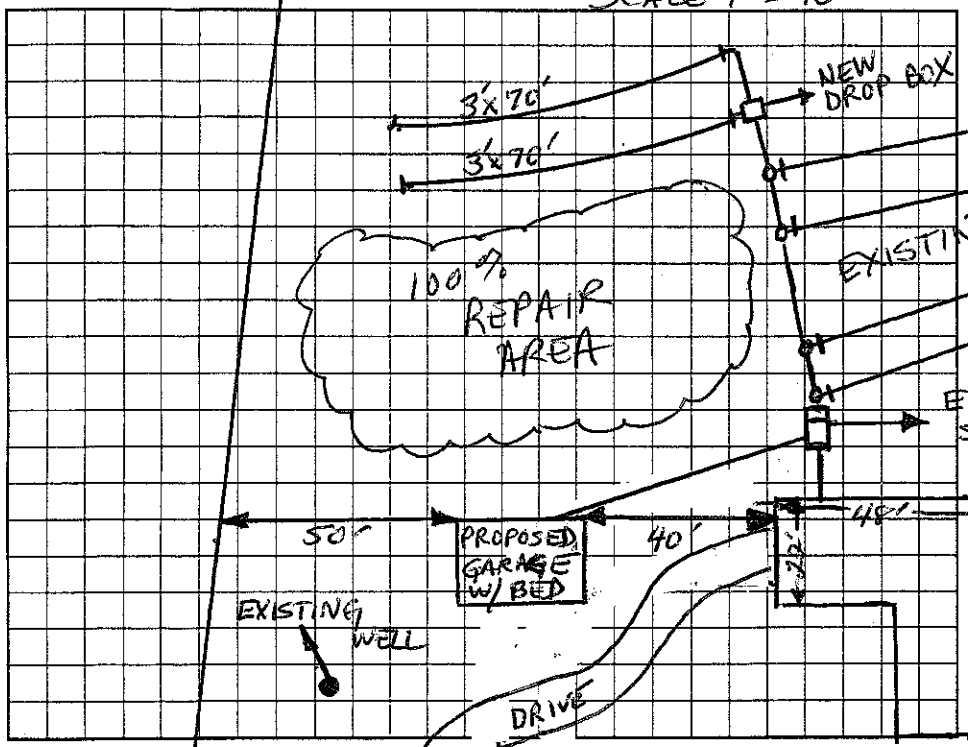

AS BUILT SKETCH

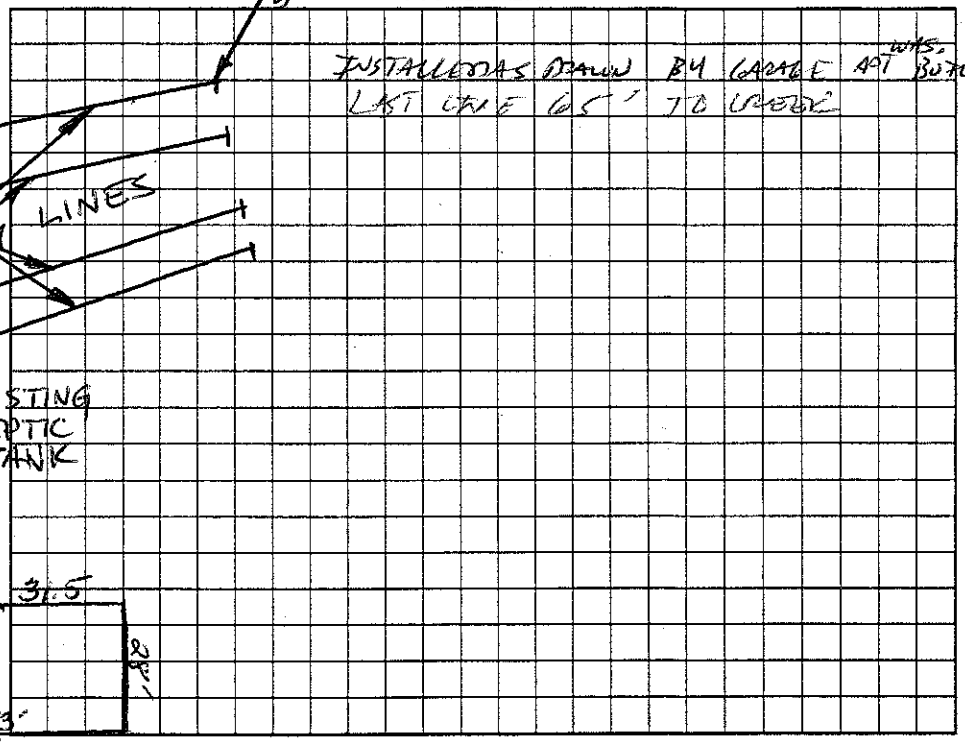

Permit can be suspended or revoked if any false information is supplied toward securing the permit/any unauthorized changes are made to the site/any unauthorized changes are made in the installation of the system. Improvement Permit with plat valid without expiration. Improvement Permit with site plan valid for sixty months. Authorization to Construct is valid for a period equal to that of Improvement Permit – not to exceed sixty months.

Signed: Andie H. Seigworth date 08/19/04 Installed by: SAMMY BEAVERS

Improvement Permit by: Christopher Shuler RS date 8-18-04 Operation Permit by: Christopher Shuler RS date 10-5-04

Authorization to Construct by: Christopher Shuler RS date 8-18-04 ~~Existing System~~ Inspection by: date

HEALTH DEPT. COPY: WHITE OWNER COPY (FINAL): YELLOW OWNER COPY (INITIAL): PINK