IREDELL COUNTY HEALTH DEPARTMENT

STATESVILLE 704-878-5305 MOORESVILLE 704-664-5281

IMPROVEMENT PERMIT / AUTHORIZATION TO CONSTRUCT / OPERATION PERMIT / EXISTING SYSTEM INSPECTION

PERMIT# 074678 PIN# 4831 84 6915 DATE 7-14-98

OWNER OR CONTRACTOR WILLIAM K. SEIGWORTH PHONE: Business (704) 366-8551 Home (704) 513-3625

ADDRESS 203 KIMROD LANE, CHARLOTTE, NC 28270

LOCATION US 21 N, TL JENNINGS ROAD, TL MT. VERNON, TR EUPEPTIC SPRINGS, LOT on LEFT ACROSS FROM CURRENT ROAD

SUBDIVISION _____ BLOCK / SECTION _____ LOT _____ LOT AREA 7.24 ACRES SITE CLASS. PS DESIGN FLOW 360 L.T.A.R. 0.30 GPD/FT2

Septic Tank: 1000 Gallons; STB 1012 Date 7-10-98
Pump Tank: _____ Gallons; PT _____ Date _____
Pump Make: _____ Model _____ Serial No. _____
Nitrification Field: No Fields 1 Square Feet 1200 Linear Feet 400
No Lines FOUR Trench Width 36" Max Trench Bottom Depth 36" Gravel Depth 12"

☒ New System ☐ Repair System Type: I, II, III, IV, V, VI
System Description: CONVENTIONAL GRAVITY
Repair System Description: CONV. GRAVITY
Maintenance Agreement Required: ☐ Yes ☒ No


☒ House/Mod. Home No. Bedrooms 3
☐ Mobile Home No. Bathrooms 2
☐ Business No. Employees ____
☐ Other _____
☐ Slab ☐ Crawl Space ☒ Basement w/plumbing ☐ Basement wo/plumbing

Water Supply: ☒ Individual ☐ Public ☐ Community WELL

Comments:/Conditions: BRANCH

Comments:/Conditions:

INITIAL SITE SKETCH

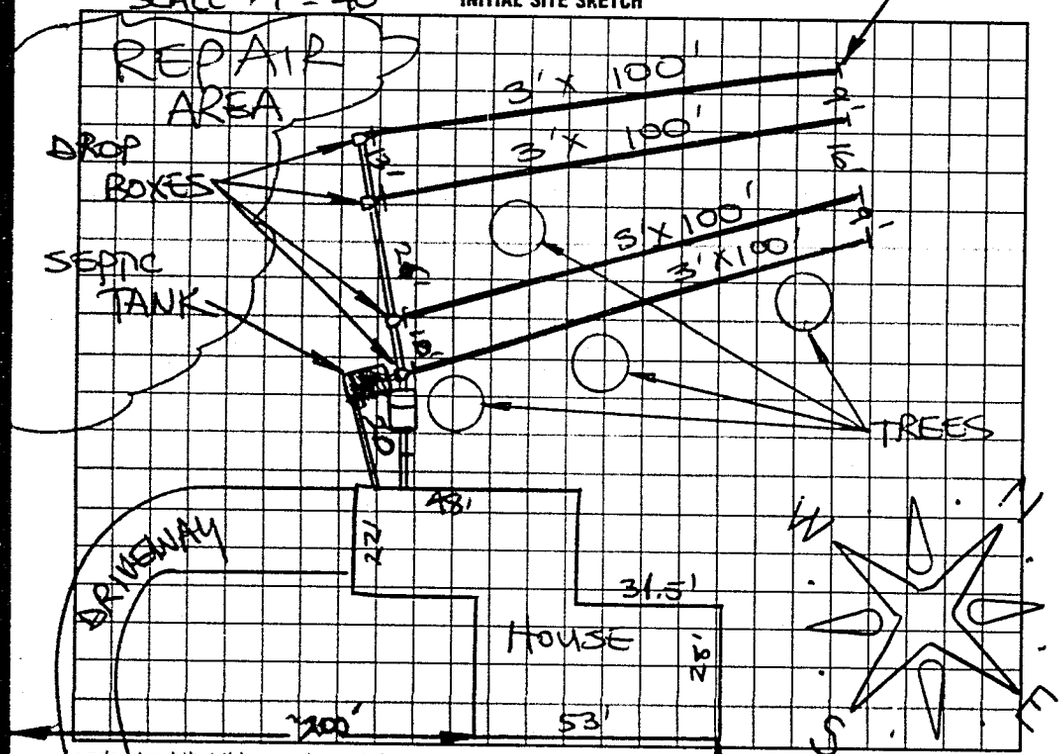

AS BUILT SKETCH

SYSTEM INSTALLED ACCORDING TO INITIAL SITE SKETCH

I understand that this permit can be suspended or revoked if any false information is supplied toward securing the permit/any unauthorized changes are made to the site/any unauthorized changes are made in the installation of the system. Improvement Permit with plat valid without expiration. Improvement Permit with site plan valid for sixty months. Authorization to Construct is valid for a period equal to that of Improvement Permit – not to exceed sixty months.

Signed: W.K. Seigworth date 7-14-98 Installed by: TOMMY FRYE

Improvement Permit by: STEVE HENDRICK date 7-14-98 Operation Permit by: STEVE HENDRICK date 9-10-98

Authorization to Construct by: STEVE HENDRICK date 7-14-98 Existing System Inspection by _____ date _____

HEALTH DEPT COPY: WHITE INSPECTION COPY (FINAL): GREEN OWNER COPY (FINAL): YELLOW INSPECTION COPY (INITIAL): PINK OWNER COPY (INITIAL): GOLD

9 E 1 0 0