IREDELL COUNTY HEALTH DEPARTMENT

CE William Seigworth Permit # 202666

STATESVILLE 704-878-5305 MOORESVILLE 704-664-5281

IMPROVEMENT PERMIT / AUTHORIZATION TO CONSTRUCT / OPERATION PERMIT / EXISTING SYSTEM INSPECTION

PERMIT# 115318 PIN# 4831-84-6915 DATE 8/18/04

OWNER OR CONTRACTOR WILLIAM K. SEIGWORTH PHONE: Business _____ Home (704) 539-4889

ADDRESS 437 EUPEPTIC SPRINGS RD. OUN NC 28660 (#437)

LOCATION I-77N TL TOMLIN MILL RD TR JENNINGS TL MT. VERNON CH RD TR EUPEPTIC SPRS RD CROSS BRIDGE 2ND BOX ON LEFT

SUBDIVISION _____ BLOCK / SECTION _____ LOT _____ LOT AREA 1.0 SITE CLASS. PS DESIGN FLOW 480 L.T.A.R. 0.3 gpd/Ft 2

Septic Tank: 1000 EX. Gallons; STB _____ Date _____

Pump Tank: _____ Gallons; PT _____ Date _____

Pump Make: _____ Model _____ Serial No. _____

Nitrification Field: No Fields 1 Square Feet _____ Linear Feet 140'

No Lines 2 Trench Width 36" Max Trench Bottom Depth 36" Gravel Depth 12"

☑ New System ☐ Repair System Type: I (II) III, IV, V, VI

System Description: CON. GRAVITY

Repair System Description: SAME

Maintenance Agreement Required: ☐ Yes ☑ No

☑ House/Mod. Home No. Bedrooms 4

☐ Mobile Home No. Bathrooms 3

☐ Business No. Employees ____

☐ Other _____


☑ Slab ☐ Crawl Space ☐ Basement w/plumbing ☐ Basement wo/plumbing

Water Supply: ☑ Individual ☐ Public ☐ Community


Comments/Conditions: (1) ADDING 1 BEDROOM GARAGE ONTO EXISTING 3-BEDROOM SYSTEM, BRINGING TOTAL LINEAR FOOTAGE TO 540 LIN. FT. FOR WHOLE SYSTEM

Comments/Conditions: SPRING ST STREET

INITIAL SITE SKETCH SCALE 1"=40'

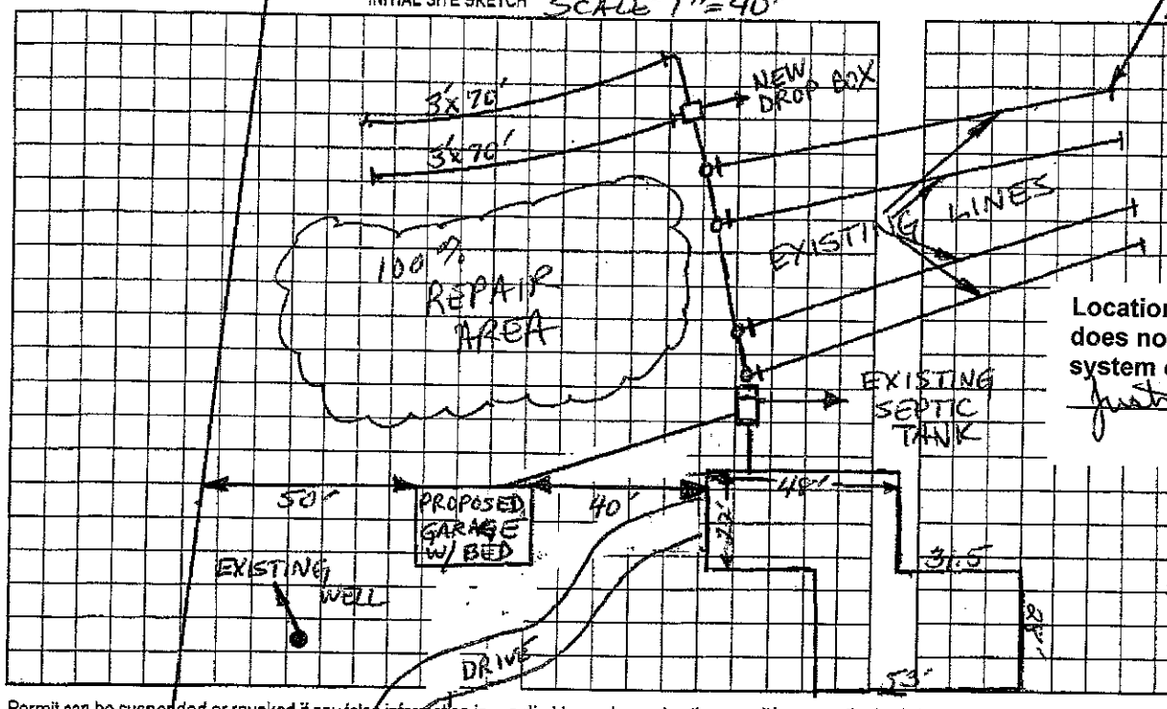

AS BUILT SKETCH

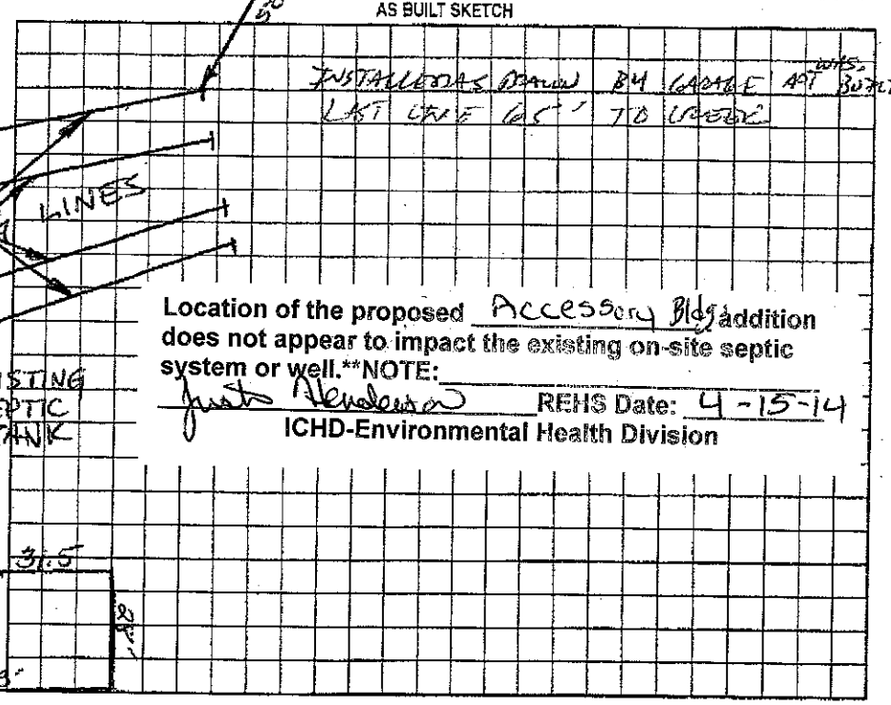

Location of the proposed Accessory Bldg addition does not appear to impact the existing on-site septic system or well.**NOTE: _____

Justin Henderson REHS Date: 4-15-14

ICHD-Environmental Health Division

Permit can be suspended or revoked if any false information is supplied toward securing the permit/any unauthorized changes are made to the site/any unauthorized changes are made in the installation of the system. Improvement Permit with plat valid without expiration. Improvement Permit with site plan valid for sixty months. Authorization to Construct is valid for a period equal to that of Improvement Permit – not to exceed sixty months.

Signed: Andie H. Seigworth date 08/19/04

Improvement Permit by: Christopher Shell PS date 8-18-04

Authorization to Construct by: Christopher Shell PS date 8-18-04

Installed by: SAMMY REAVES

Operation Permit by: Christopher Shell RS date 10-5-04

~~Existing System~~ Inspection by: _____ date _____

HEALTH DEPT. COPY: WHITE OWNER COPY (FINAL): YELLOW OWNER COPY (INITIAL): PINK

Acc Bldg.