IREDELL COUNTY HEALTH DEPARTMENT

STATESVILLE 704-878-5305 MOORESVILLE 704-664-5281

IMPROVEMENT PERMIT / AUTHORIZATION TO CONSTRUCT / OPERATION PERMIT / EXISTING SYSTEM INSPECTION

PERMIT# 077833 PIN# 4822 96 9303 (PT) DATE 12-2-98

OWNER OR CONTRACTOR ROBIN SCOTT PHONE: Business 872-8141 Home 592-900

ADDRESS 179 AYCOCK ROAD, STATESVILLE, NC 28677

LOCATION NC115 N, TR PROSPECT ROAD, TL AYCOCK ROAD, 0.2 MILE ON LEFT

SUBDIVISION BLOCK / SECTION LOT LOT AREA 1.00 ACRE SITE CLASS PS DESIGN FLOW 360 L.T.A.R. 0.40 GPD/FT²

Septic Tank: 1000 Gallons STB 156 Date 11-30-98

Pump Tank: Gallons PT Date

Pump Make: Model: Serial No.

Nitrification Field: No. Fields 1 Square Feet 900 Linear Feet 300

No. Lines THREE Trench Width 36" Max. Trench Bottom Depth 36"

✓ New System Repair System Type I II III IV V

System Description CONVENTIONAL GRAVITY

Repair System Description CONV. PUMP

Maintenance Agreement Required? Yes No ✓

Gravel Depth 12" Slab Crawl Space Basement w/plumbing Basement w/o plumbing

✓ House/Mod. Home No. Bedrooms 3

✓ Mobile Home No. Bathrooms 2

Business No. Employees

Other


Water Supply: ✓ Individual ☐ Public ☐ Community WELL

Comments/Conditions: KEEP SYSTEM MINIMUM 100 FEET FROM WELL

Comments/Conditions:

SCALE: 1"=50'

INITIAL SITE SKETCH

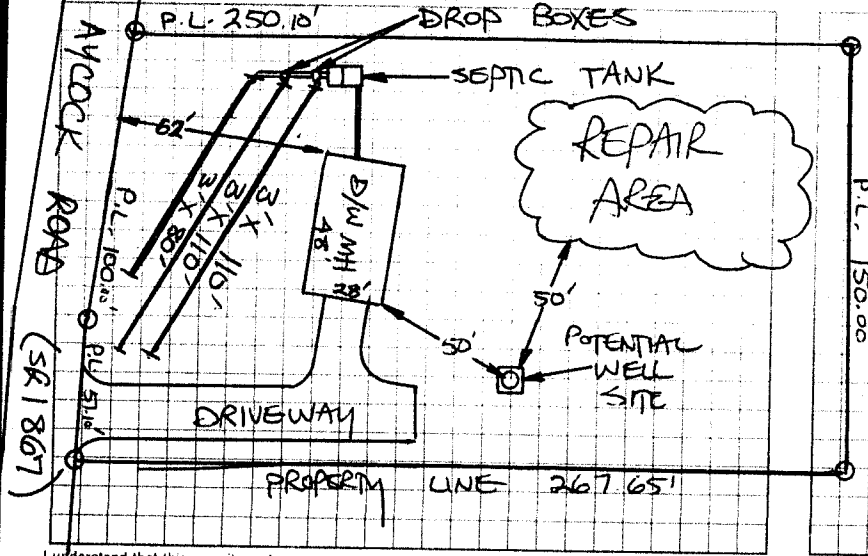

AS BUILT SKETCH

SYSTEM INSTALLED ACCORDING TO INITAL SITE SKETCH

I understand that this permit can be suspended or revoked if any false information is supplied toward securing the permit/any unauthorized changes are made to the site/any unauthorized changes are made in the installation of the system. Improvement Permit with plat valid without expiration. Improvement Permit with site plan valid for sixty months. Authorization to Construct is valid for a period equal to that of Improvement Permit – not to exceed sixty months.

Signed: Robin Scott date 12-2-98

Improvement Permit by: STEVE HEDRICK date 12-2-98

Authorization to Construct by: STEVE HEDRICK date 12-2-98

Installed by: BILLY GRIMES

Operation Permit by: STEVE HEDRICK date 3-15-00

Existing System Inspection by: date

HEALTH DEPT. COPY: WHITE INSPECTION COPY (FINAL): GREEN OWNER COPY (FINAL): YELLOW INSPECTION COPY (INITIAL): PINK OWNER COPY (INITIAL): GOLD