57631

IREDELL COUNTY HEALTH DEPARTMENT

STATESVILLE 704-878-5305 MOORESVILLE 704-664-5281

IMPROVEMENT PERMIT / CERTIFICATE OF COMPLETION / OPERATION PERMIT / EXISTING SYSTEM INSPECTION

PROPERTY DESCRIPTION NO. 22116 DATE 9-18-95 TAX MAP NO. 15F-A-49 Watershed: ☐ Yes ☑ No

OWNER OR CONTRACTOR OLA S. CLINE PHONE: Business Home 876-6821

ADDRESS 168 POVERTY HILL LN, STATESVILLE NC 28677

LOCATION NC 115 N TO PROSPECT CH. RD, ON (R) BEFORE MYERS MILL ROAD

SUBDIVISION BLOCK / SECTION LOT LOT AREA .65 AC SITE CLASS PS DESIGN FLOW 240 L.T.A.R. EXISTING

Septic Tank: 1000 Gallons; STB Date
Pump Tank: Gallons; PT Date
Pump Make: Model Serial No.
Nitrification Field: No Fields Square Feet Linear Feet EXISTING
No Lines EXISTING Trench Width Max Trench Bottom Depth Gravel Depth

☐ New System ☐ Repair System Type: I (II) III IV V VI
System Description: CONVENTIONAL GRAVITY
Repair System Description:
Maintenance Agreement Required: ☐ Yes ☑ No
☐ Slab ☑ Crawl Space ☐ Basement w/plumbing ☐ Basement wo/plumbing


☐ House/Mod. Home No. Bedrooms 3
☑ Mobile Home No. Bathrooms 2
☐ Business No. Employees
☐ Other

Water Supply:
☑ Individual
☐ Community
☐ Public
WELL


Comments:

Comments: KEEP MH MINIMUM 5' FROM SYSTEM

INITIAL SITE SKETCH

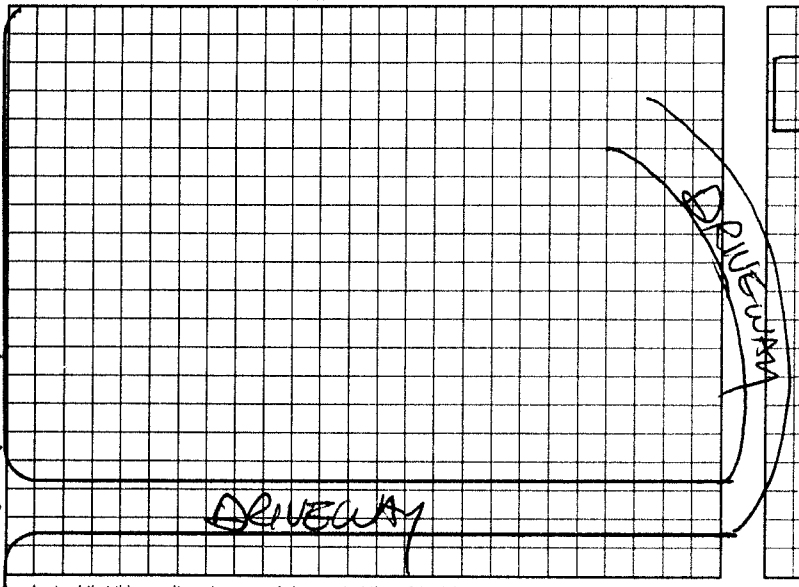

AS BUILT SKETCH

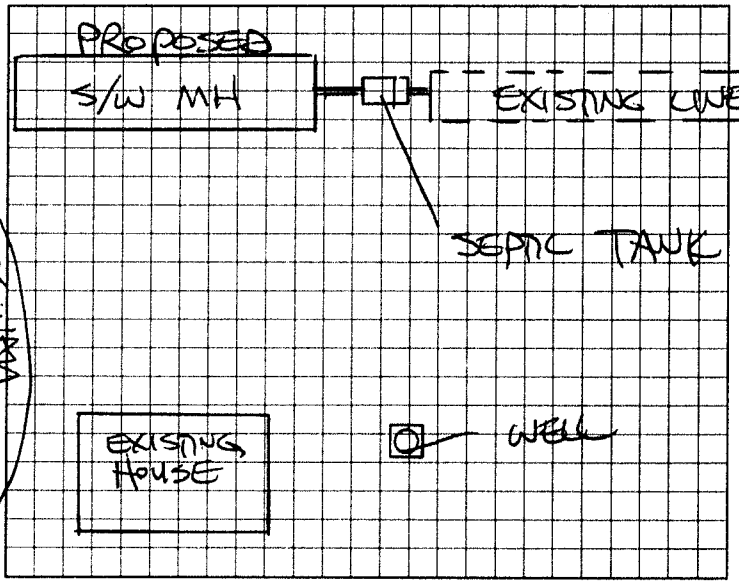

PROSPECT CHURCH ROAD

I understand that this permit can be suspended or revoked if any false information is supplied toward securing the permit/any unauthorized changes are made to the site/any unauthorized changes are made in the installation of the system.

Signed: Installed by:

Improvement Permit by: date Certificate of Completion by date

Existing System Inspection by: STEVE HENRICK date 9-18-95 Operation Permit by: date

HEALTH DEPT. COPY: WHITE INSPECTION COPY (FINAL): GREEN OWNER COPY (FINAL): YELLOW INSPECTION COPY (INITIAL): PINK OWNER COPY (INITIAL): GOLD