IREDELL COUNTY HEALTH DEPARTMENT

STATESVILLE 704-878-5305 MOORESVILLE 704-664-5281

IMPROVEMENT PERMIT / AUTHORIZATION TO CONSTRUCT / OPERATION PERMIT / EXISTING SYSTEM INSPECTION

PERMIT # 6031 PIN # 4832-15-0572 DATE 3-23-10

OWNER or APPLICANT James R. Williams PHONE: Business Home: 704 592 5943 / 704-880-4364

OWNER or APPLICANT ADDRESS 204 Prospect Rd

LOCATION / DIRECTIONS 115N, (R) on Prospect Rd, 1 mile ± m/h on left just past Aycock

SUBDIVISION n/a BLOCK / SECTION n/a LOT # LOT AREA 4.93 Ac DESIGN FLOW 360 L.T.A.R. Ex

Septic Tank 1000 Gallons: STB Date

Pump Tank Gallons: PT Date

Pump Make Model Serial #

Nitrification Field No Fields 1 No Lines Ex Linear Feet Ex ~ 250ish'

Trench Width Ex Max. Trench Bottom Depth Ex. Gravel Depth Ex. ☑ GRAVITY ☐ PRESSURE

☐ New System ☐ Repair ☐ Expansion System Type I (II) III IV V VI

System Description: Existing

Repair System Description: 25% Reduction

Maintenance Agreement Required ☐ YES ☒ NO

☒ Residence No. Bedrooms 3

☐ Business No. Persons

☐ Other No. Employees

☐ Slab ☒ Crawl Space

☐ Basement w/plumbing ☐ Basement w/o plumbing

Water Supply: ☒ Private ☐ Public ☐ Community


Comments / Conditions

Comments / Conditions

No permit Found system probed

INITIAL SITE SKETCH

AS BUILT SKETCH

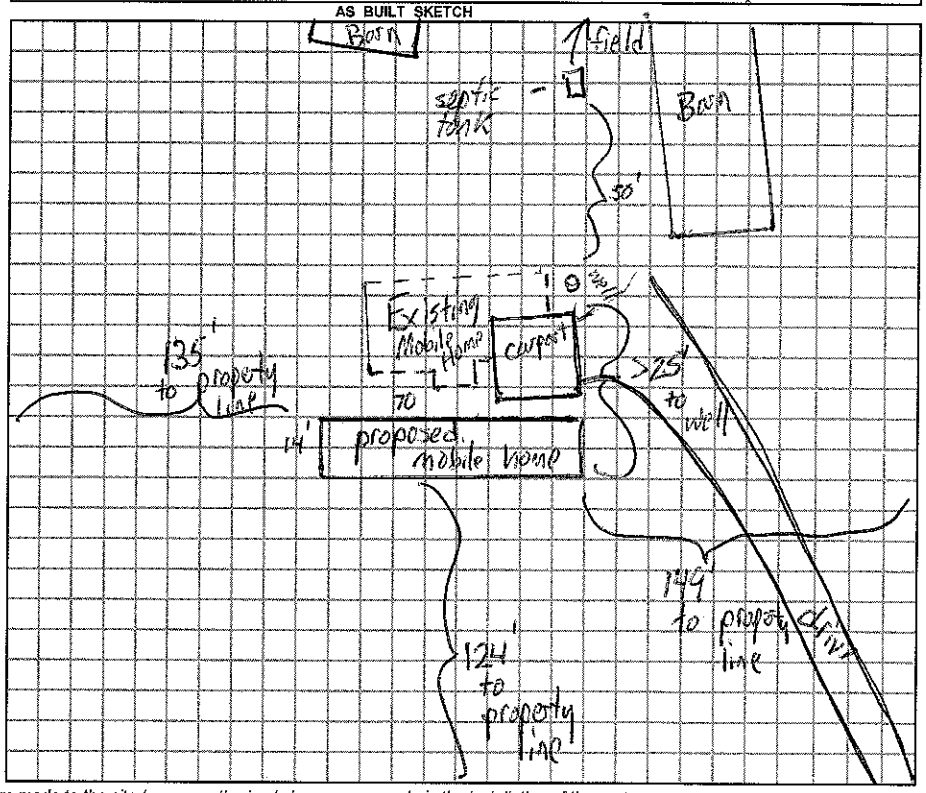

Permit can be suspended or revoked if any false information is supplied toward securing the permit / any unauthorized changes are made to the site / any unauthorized changes are made in the installation of the system.

☐ *IMPROVEMENT PERMIT w / plat valid without expiration.* ☒ *IMPROVEMENT PERMIT w / site plan valid for 60 mos.* ☒ *AUTHORIZATION TO CONSTRUCT valid for period equal to IMPROVEMENT PERMIT-not to exceed 60 mo.*

Owner / Applicant Signature: James Riley Williams Date 3-23-10 Installed by:

Improvement Permit by: Date

Authorzation to Construct by: Date

Operation Permit by: Date:

Existing System Inspected by: James Date: 3-23-10

YOU SHOULD CONTACT A LOCATOR SERVICE PRIOR TO ANY EXCAVATION.

WHITE COPY Environmental Health YELLOW COPY (Final) Owner / Applicant PINK COPY (Initial) Owner / Applicant