IREDELL COUNTY HEALTH DEPARTMENT

STATESVILLE 704-878-5305 MOORESVILLE 704-664-5281 52273

IMPROVEMENT PERMIT / CERTIFICATE OF COMPLETION / OPERATION PERMIT / EXISTING SYSTEM INSPECTION

PROPERTY DESCRIPTION NO. 18484 DATE 5/13/94 TAX MAP NO. 15F - A - 78

OWNER OR CONTRACTOR DAVID PREVETTE PHONE: Business Watershed: ☐ Yes ☑ No

ADDRESS [redacted] 155 PROSPECT ROAD STVL NC 28677 Home 592-2112

LOCATION NC 115 N, TR PROSPECT ROAD, O'N (R) JUST BEFORE MYERS MILL RD

SUBDIVISION BLOCK / SECTION LOT LOT AREA 208 x 417' SITE CLASS. PS DESIGN FLOW 360 L.T.A.R. 0.35 GPD/FT2

Septic Tank: 1000 Gallons; STB 1012 Date 4/25/94

Pump Tank: Gallons; PT Date

Pump Make: Model Serial No.

Nitrification Field: No Fields 1 Square Feet 1035 Linear Feet 345

No Lines 3 Trench Width 36" Max Trench Bottom Depth 28" Gravel Depth 12"

☑ New System ☐ Repair System Type: I, II, III, IV, V, VI

System Description: CONV. GRAVITY

Repair System Description: CONV. GRAVITY

Maintenance Agreement Required: ☐ Yes ☑ No

☑ House/Mod. Home No. Bedrooms 3

☐ Mobile Home No. Bathrooms 2

☐ Business No. Employees

☐ Other


☐ Slab ☑ Crawl Space ☐ Basement w/plumbing ☐ Basement wo/plumbing

Water Supply: ☑ Individual ☐ Community ☐ Public WELL

Comments: (1) KEEP SYSTEM MINIMUM 100' from WELL
(2) INSTALL LINES NO DEEPER THAN 28"

Comments:

INITIAL SITE SKETCH

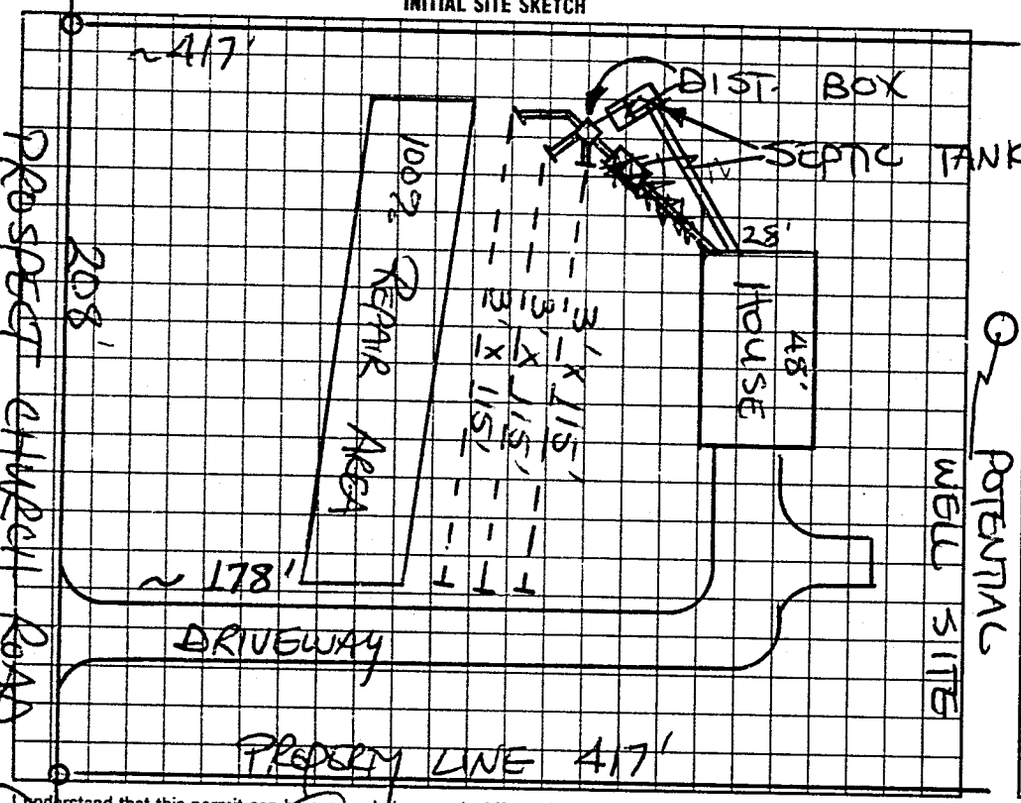

AS BUILT SKETCH

SYSTEM INSTALLED ACCORDING TO INITAL SITE SKETCH

I understand that this permit can be suspended or revoked if any false information is supplied toward securing the permit/any unauthorized changes are made to the site/any unauthorized changes are made in the installation of the system. Improvement Permit is valid for 60 months from date of issuance.

Signed: X

Improvement Permit by: STEVE HEDRICK date 5/13/94

Existing System Inspection by: date

Installed by: JEFF HURLBUT / JR. HARTNESS

Certificate of Completion by: STEVE HEDRICK date 8/2/94

Operation Permit by: date

HEALTH DEPT. COPY: WHITE INSPECTION COPY (FINAL): GREEN OWNER COPY (FINAL): YELLOW INSPECTION COPY (INITIAL): PINK OWNER COPY (INITIAL): GOLD