IREDELL COUNTY HEALTH DEPARTMENT

PRIVATE DRINKING WATER WELL PERMIT # 207236 **PIN #** 4832341782

Statesville Office – Central Permitting (704) 878-5305 Mooresville Office (704) 660-3625

Type of Permit (circle one): New Repair **Abandonment**


APPLICANT NAME: Clay Lunsford ADDRESS: 6245 Wilkesboro Hwy Statesville NC PHONE: 704-880-3698

DIRECTIONS TO SITE: @ the intersection of myers mill & Prospect Rd

SITE ADDRESS: 781 Myers Mill Rd Statesville NC SUBDIVISION: N/A SECTION/LOT: N/A

Initial Site Sketch

"As Built" Sketch

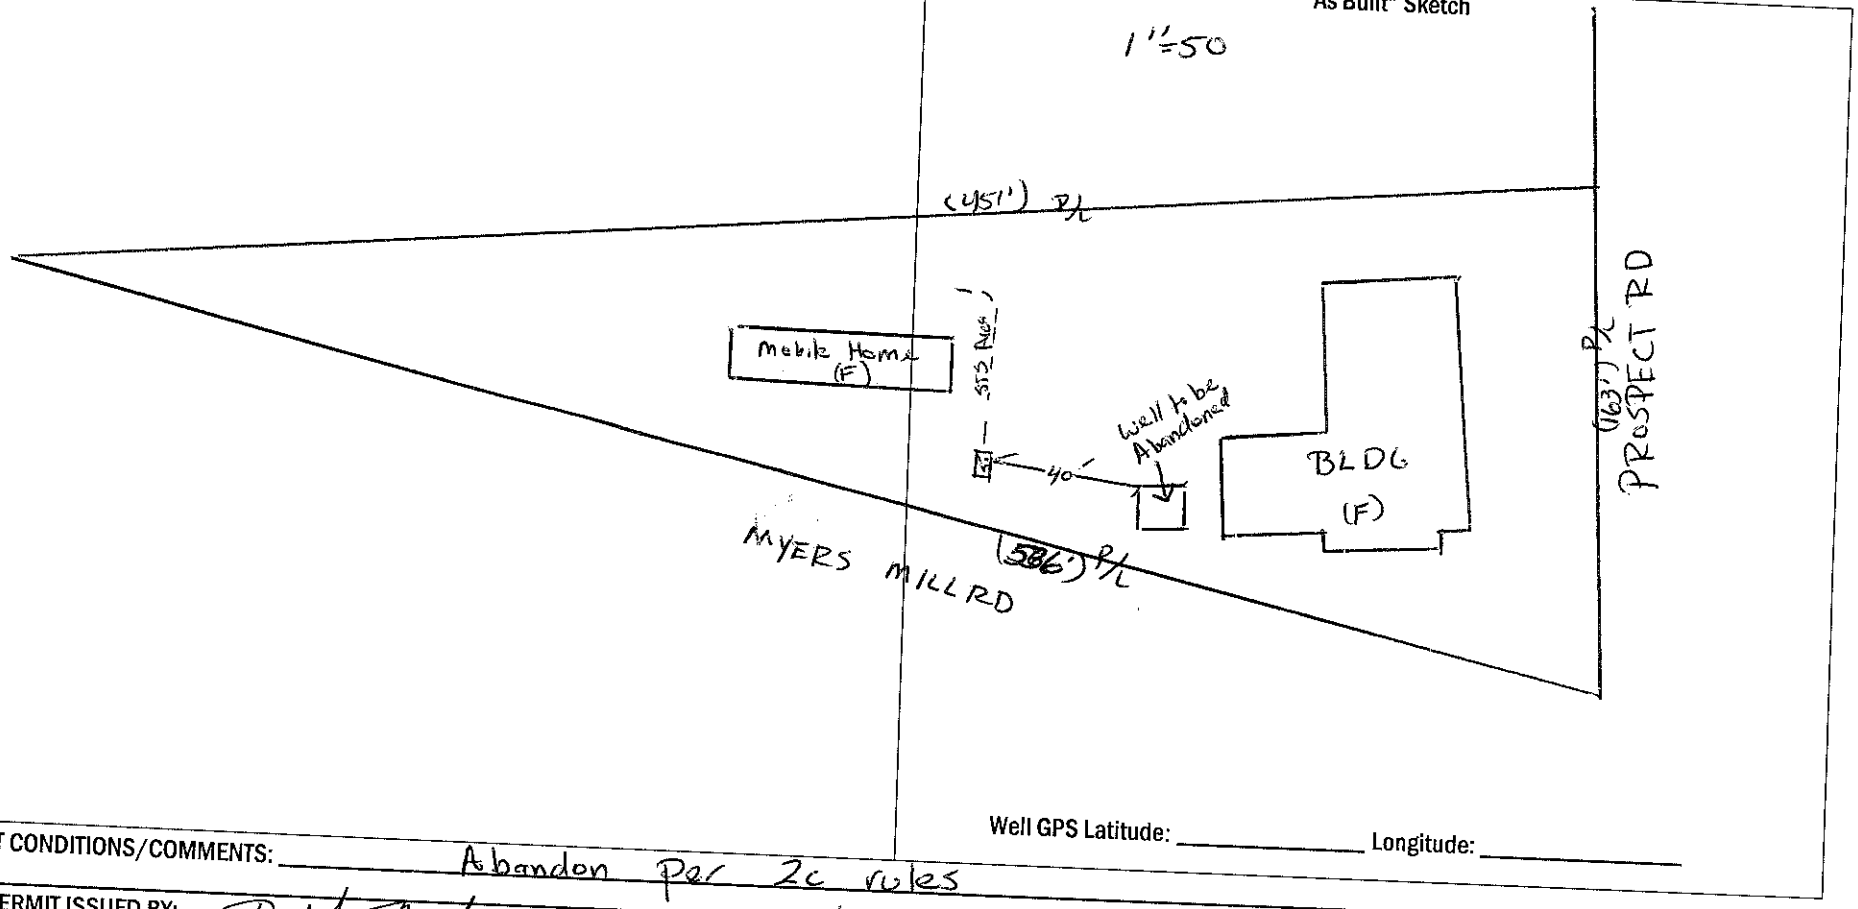

Well GPS Latitude: _____ Longitude: _____

PERMIT CONDITIONS/COMMENTS: Abandon Per 2c rules

WELL PERMIT ISSUED BY: Robert A Lee DATE: 12/04/19 (Permit is valid for 5 years from date issued. This permit may be revoked if it is determined there has been a material change in any fact or circumstance upon which the permit is issued. Actions of the employees of the Iredell County Health Department shall in no way be taken as a guarantee that this well will produce water of any particular quantity or quality or for any amount of time. Employees of the Iredell County Health Department assume no liability for any damages, either direct or consequential which may be caused by this well.)

Well Contractor: Alan Dellinger CONTRACTOR CERT #: 20094 GROUT INSPECTION BY: Robert A Lee DATE: 12/15/19

OR CERTIFICATION OF GROUT NOT WITNESSED BY DEPT: _____ DATE: _____ WELL HEAD INSPECTION BY: _____ DATE: _____

WELL HEAD INSPECTION (check when completed): GROUT TO GROUND SURFACE ☐ WELL CONTRACTOR ID PLATE ☐ PUMP INSTALLER ID PLATE ☐ SAMPLE PORT ☐

ACCESS PORT / VENT ☐ WELL SEAL ☐ WELL HEAD 12 INCHES / PITLESS ADAPTOR 8 INCHES ABOVE GRADE ☐

CERTIFICATE OF COMPLETION BY: _____ DATE: _____ WATER SAMPLES BY: _____ DATE: _____

Attachments: Form GW-1a (required except for abandonment) ☐ Form GW-30 ☐ Water Sample Results ☐ Plat ☐

Health Dept. Copy - White Applicant Certificate of Completion - Yellow Applicant Well Construction Permit - Pink