64407

IREDELL COUNTY HEALTH DEPARTMENT

STATESVILLE 704-878-5305 MOORESVILLE 704-664-5281

IMPROVEMENT PERMIT / CERTIFICATE OF COMPLETION / OPERATION PERMIT / EXISTING SYSTEM INSPECTION

PROPERTY DESCRIPTION NO. 2545i DATE 11-12-96 TAX MAP NO. 15E-A-30 Watershed: ☐ Yes ☑ No

OWNER OR CONTRACTOR Gary Baggarley PHONE: Business Home 872-4243

ADDRESS 1421 Mars Vista Dr.

LOCATION N.C. 115 N TR Property on Rt at end Th Myers Mill 1/2 mi left on Jackson Rd at Box 955

SUBDIVISION BLOCK / SECTION LOT LOT AREA 93 acres SITE CLASS. PS DESIGN FLOW 240 L.T.A.R.

Septic Tank: 1000 Gallons; STB 1017 Date 11-26-96 ☑ New System ☐ Repair System Type: I, II, III, IV, V, VI

Pump Tank: Gallons; PT Date System Description: Conv. Gravity

Pump Make: Model Serial No. Repair System Description:

Nitrification Field: No Fields 1 Square Feet 720 Linear Feet 240 Maintenance Agreement Required: ☐ Yes ☑ No

No Lines 3 Trench Width 36" Max Trench Bottom Depth 36" Gravel Depth 12"

☐ House/Mod. Home No. Bedrooms 2
☐ Mobile Home No. Bathrooms 1
☐ Business No. Employees
☐ Other


☐ Slab ☑ Crawl Space ☐ Basement w/plumbing ☐ Basement wo/plumbing

Water Supply: ☑ Individual ☐ Community ☐ Public

Comments:

Comments:

INITIAL SITE SKETCH

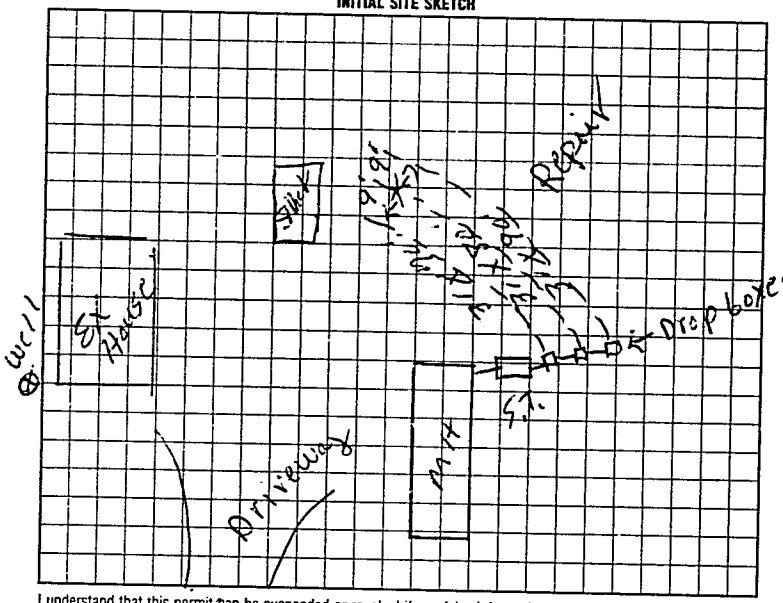

AS BUILT SKETCH

Same as initial sketch

I understand that this permit can be suspended or revoked if any false information is supplied toward securing the permit/any unauthorized changes are made to the site/any unauthorized changes are made in the installation of the system.

Signed: X Gary Baggarley

Improvement Permit by: L.C. Moore date 11-12-96

Existing Inspection by: L.C. Moore date 11-12-96

Installed by: A-1 Backhoe

Certificate of Completion by: date

Operation Permit by L.C. Moore date 11-13-96

HEALTH DEPT. COPY: WHITE — INSPECTION COPY (FINAL): GREEN — OWNER COPY (FINAL): YELLOW — INSPECTION COPY (INITIAL): PINK — OWNER COPY (INITIAL): GOLD

Authorization to Const. Authorization to Const. EXPIRES 60 mos from issue