IREDELL COUNTY HEALTH DEPARTMENT

STATESVILLE 704-878-5305 MOORESVILLE 704-664-5281

IMPROVEMENT PERMIT / AUTHORIZATION TO CONSTRUCT / OPERATION PERMIT / EXISTING SYSTEM INSPECTION

PERMIT# 089080 PIN# 4832541694 (PT) DATE 5-16-00

OWNER OR CONTRACTOR MIKE GOODENOW PHONE: Business Home 592-5370

ADDRESS 677 TRUMPET BRANCH RD, STATESVILLE, NC 28625

LOCATION NC 115 N, TR PROSPECT CH. RD, CONTINUE TRUMPET BRANCH RD, BEHIND 3RD HOUSE ON RIGHT (#677)

SUBDIVISION BLOCK / SECTION LOT LOT AREA 8.8 ACRES SITE CLASS PS DESIGN FLOW 360 L.T.A.R. 0.30 GPD/FT²

Septic Tank: 1000 Gallons; STB 1012 Date 1-10-00
Pump Tank: Gallons; PT Date
Pump Make: Model Serial No
Nitrification Field: No Fields 1 Square Feet 1200 Linear Feet 400
No Lines THREE Trench Width 36" Max Trench Bottom Depth 36" Gravel Depth 12"

☒ New System ☐ Repair System Type: I (II) III IV V VI
System Description: CONVENTIONAL GRAVITY
Repair System Description: CONV. PUMP. FED
Maintenance Agreement Required: ☐ Yes ☒ No

☐ House/Mod. Home ☒ Mobile Home ☐ Business ☐ Other
No. Bedrooms 3 No. Bathrooms 2 No. Employees


☐ Slab ☒ Crawl Space ☐ Basement w/plumbing ☐ Basement wo/plumbing

Water Supply: ☒ Individual ☐ Public ☐ Community
WELL NEXT DOOR


Comments:/Conditions:

Comments:/Conditions SEPTIC TANK WITH RISERS INSTALLED USING "POLYLOK" FILTER

INITIAL SITE SKETCH

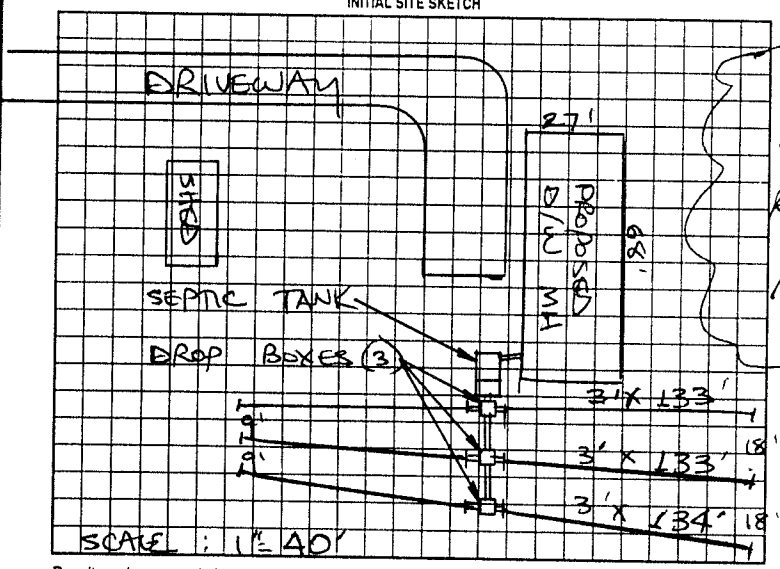

AS BUILT SKETCH

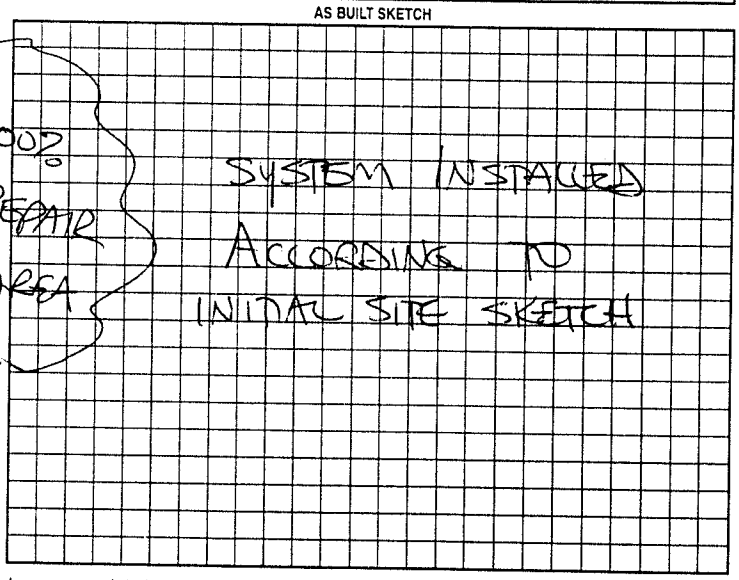

Permit can be suspended or revoked if any false information is supplied toward securing the permit/any unauthorized changes are made to the site/any unauthorized changes are made in the installation of the system. Improvement Permit with plat valid without expiration. Improvement Permit with site plan valid for sixty months. Authorization to Construct is valid for a period equal to that of Improvement Permit – not to exceed sixty months.

Signed: Michael E Goodenow date 5-16-00 Installed by: A-1 BACKHOE

Improvement Permit by: STEVE HEDRICK date 5-16-00 Operation Permit by: STEVE HEDRICK date 5-26-00

Authorization to Construct by: STEVE HEDRICK date 5-16-00 Existing System Inspection by: date

HEALTH DEPT. COPY: WHITE OWNER COPY (FINAL): YELLOW OWNER COPY (INITIAL): PINK