IREDELL COUNTY HEALTH DEPARTMENT

STATESVILLE 704-878-5305 MOORESVILLE 704-664-5281

IMPROVEMENT PERMIT / AUTHORIZATION TO CONSTRUCT / OPERATION PERMIT / EXISTING SYSTEM INSPECTION

PERMIT# 138322 PIN# 4832657495 DATE 10-11-06

OWNER OR APPLICANT Jane Rash PHONE: Business Home 704-902-2743

ADDRESS 221 Gurney Road Olin NC 28660

LOCATION 21N (L) Jennings (R) Trumpet Branch (R) Dowell RD 1st driveway Right

SUBDIVISION BLOCK / SECTION LOT LOT AREA 2.1859 SITE CLASS. DESIGN FLOW 360 L.T.A.R.

Septic Tank: 1000 Gallons; STB Short 1760 Date 9-29-06
Pump Tank: Gallons; PT Date
Pump Make: Model Serial No.
Nitrification Field: No Fields Square Feet 1440 Linear Feet 360
No Lines 4 Trench Width 36" Max Trench Bottom Depth 20" Gravel Depth NP

☑ New System ☐ Repair ☐ Expansion System Type: I II (III) IV V VI
System Description: 25% Graded
Repair System Description: 25% Bucket
Maintenance Agreement Required: ☐ Yes ☐ No


☑ House/Mod. Home No. Bedrooms 3
☐ Mobile Home No. Persons
☐ Business No. Employees
☐ Other

Water Supply: ☑ Individual ☐ Public ☐ Community

☐ Gravity ☐ Pressure ☐ Slab ☑ Crawl Space ☐ Basement w/plumbing ☐ Basement wo/plumbing


Comments:/Conditions:
20" Trench Bottom (NOT TO SCALE) 20" Trench Bottom

INITIAL SITE SKETCH

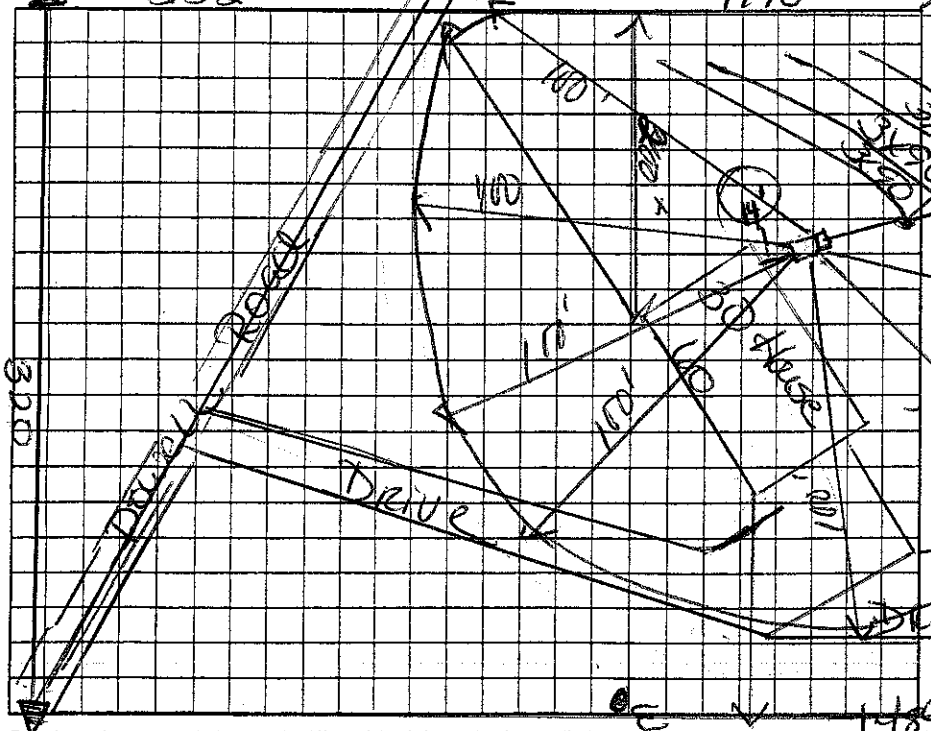

Comments:/Conditions:
Install on Contour
Maintain all setbacks
F. Haw
Install
poly lock
Blue

AS BUILT SKETCH

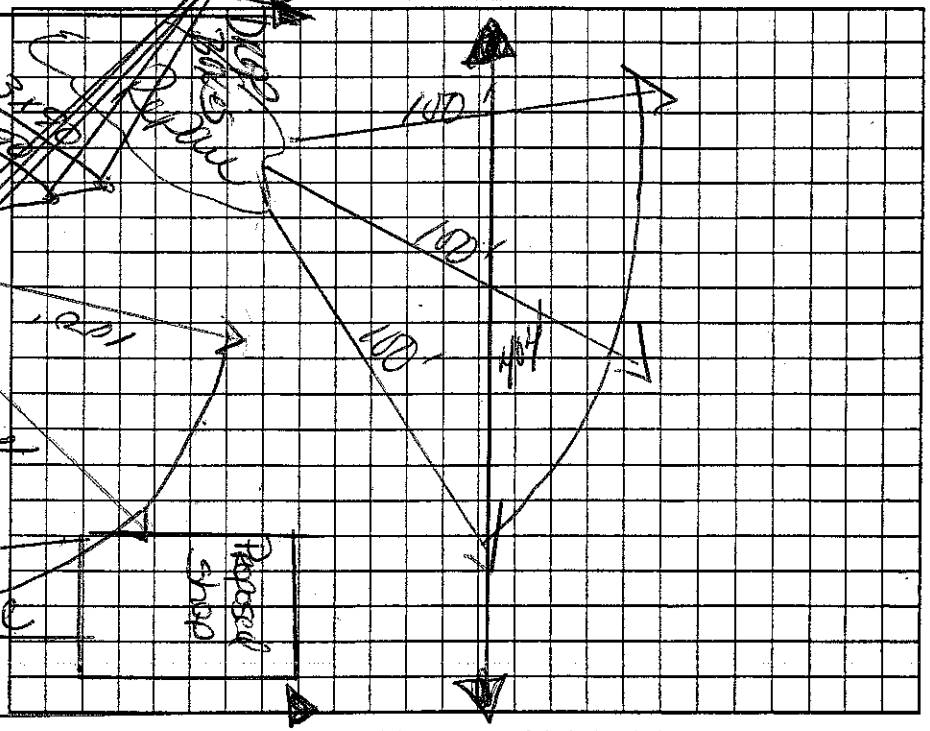

Permit can be suspended or revoked if any false information is supplied toward securing the permit/any unauthorized changes are made to the site/any unauthorized changes are made in the installation of the system. Improvement Permit with plat valid without expiration ☐ Improvement Permit with site plan valid for sixty months ☐ Authorization to Construct is valid for a period equal to that of Improvement Permit – not to exceed sixty months.

Signed: Eric H. Rash date

Improvement Permit by: Kelly Cook date 10-11-06

Authorization to Construct by: Kelly Cook date 10-11-06

Installed by: Abee Grading

Operation Permit by: Jim Nipp date 12 Dec 06

Existing System Inspection by: date

HEALTH DEPT. COPY: WHITE OWNER COPY (FINAL): YELLOW OWNER COPY (INITIAL): PINK