IREDELL COUNTY HEALTH DEPARTMENT

THIS PERMIT REPLACES PREVIOUS ISSUED 2-10-03

STATESVILLE 704-878-5305 (c) MOORESVILLE 704-664-5281

IMPROVEMENT PERMIT / AUTHORIZATION TO CONSTRUCT / OPERATION PERMIT / EXISTING SYSTEM INSPECTION

PERMIT# 11113 PIN# ~~4832-68-1390.1~~ 4832-68-0123 DATE 2-27-03

OWNER OR CONTRACTOR SHANE A. ROLLINGS PHONE: Business 704-539-4502 Home 704-663-0093

ADDRESS 140 E. IREDELL AVE, MOORESVILLE, NC 28115

LOCATION NC 115 N, TR PROSPECT CH. RD, TL MYERS MILL RD, TR DOWELL RD, 0.3 MILE ON LEFT

SUBDIVISION _____ BLOCK / SECTION _____ LOT _____ LOT AREA 1.00 ACRE SITE CLASS. PS DESIGN FLOW 360 L.T.A.R. 0.25 GPD/FT²

Septic Tank: 1000 Gallons; STB 1012 Date 9-8-02

Pump Tank: _____ Gallons; PT _____ Date _____

Pump Make: _____ Model _____ Serial No. _____

Nitrification Field: No. Fields 1 Square Feet 360 to 1440 Linear Feet 360

No. Lines SIX Trench Width 36" Max Trench Bottom Depth 36" Gravel Depth N/A

☑ New System ☐ Repair System Type: I, II, III, IV, V, VI

System Description: 25% REDUCTION, GRAVITY

Repair System Description: 25% REDUCTION, PUMP, GRAVITY

Maintenance Agreement Required: ☐ Yes ☑ No

☑ House/Mod. Home No. Bedrooms 3

☐ Mobile Home No. Bathrooms 2

☐ Business No. Employees _____

☐ Other _____

☐ Slab ☑ Crawl Space ☐ Basement w/plumbing ☐ Basement wo/plumbing

Water Supply: ☑ Individual ☐ Public ☐ Community


WELL

Comments:/Conditions: INSTALL 25% REDUCTION SYSTEM AS SHOWN ON CONTOUR

SCALE: 1" = 50'

Comments:/Conditions: ① SEPTIC TANK WITH MARKER INSTALLED USING "TUFTITE" FILTER. ② SYSTEM INSTALLED DURING PERIOD OF WET SOIL CONDITIONS.

INITIAL SITE SKETCH

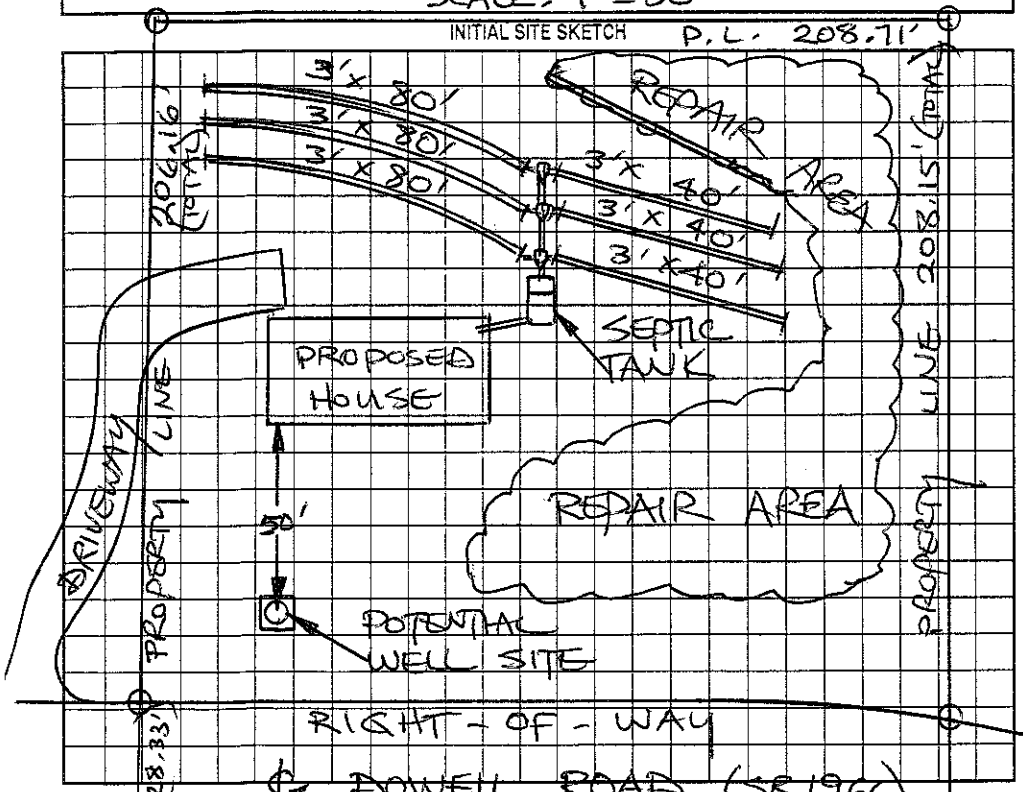

AS BUILT SKETCH

SYSTEM INSTALLED ACCORDING TO INITIAL SITE SKETCH

Permit can be suspended or revoked if any false information is supplied toward securing the permit/any unauthorized changes are made to the site/any unauthorized changes are made in the installation of the system. Improvement Permit with plat valid without expiration. Improvement Permit with site plan valid for sixty months. Authorization to Construct is valid for a period equal to that of Improvement Permit – not to exceed sixty months.

Signed: _____ date 2-27-03 Installed by: A-1 BACKHOE

Improvement Permit by: STEVE HEDRICK date 2-27-03 Operation Permit by: STEVE HEDRICK date 5-1-03

Authorization to Construct by: STEVE HEDRICK date 2-27-03 Existing System Inspection by: _____ date _____

HEALTH DEPT. COPY: WHITE OWNER COPY (FINAL): YELLOW OWNER COPY (INITIAL): PINK