# IREDELL COUNTY HEALTH DEPARTMENT

Statesville Office (704) 878-5305 Mooresville Office (704) 660-3625

BP

PERMIT # 20626

## IMPROVEMENT PERMIT / AUTHORIZATION TO CONSTRUCT / OPERATION PERMIT / EXISTING SYSTEM

PIN # 4832893116

APPLICANT: Jennifer Shumaker APPLICANT ADDRESS: 192 Waterfall Ln.

SITE ADDRESS: 280 Dowell Rd. PHONE: 704-539-5510 ALT. PHONE: N/A

SITE DIRECTIONS: Hwy 115 N TR Prospect Rd TL Myers Mill TR Dowell Rd


SUBDIVISION: N/A SECTION: N/A LOT # N/A LOT AREA: 14.25 DESIGN FLOW: 360gpd L.T.A.R.: 0.275

| | | | | | | | | | |
|---|---|---|---|---|---|---|---|---|---|
| Septic Tank | 1000 (gal) | STB | | Date | | ☑ New System ☐ Repair ☐ Expansion | System Type: I II III IV V VI | ☑ Residence | No. Bedrooms 3 |
| Pump Tank | (gal) | PT | | Date | | System Description: 25% Reduction | | ☐ Business | No. Persons 6 |
| Pump Make | | Model | | Serial # | | Repair System Description: 25% Reduction | | ☐ Other | No. Employees |
| # Nitrification Fields | 1 | # Lines | 3 | Linear Ft: | 328 | Maintenance Agreement Required: | ☐ YES ☑ NO | ☐ Slab | ☑ Crawl Space |
| Trench Width | 36" | Max. Trench Bottom Depth | 31" | Gravel Depth | N/A | ☑ GRAVITY | ☐ PRESSURE | ☐ Basement w/plumbing | ☐ Basement w/o plumbing |


Water Supply: ☑ Private ☐ Public ☐ Community

Comments / Conditions: IMPROVEMENTS ONLY! Submit recorded plat after property is sub-divided prior to issuance of CA. Install a 25% reduction system on contour with serial distribution.

INITIAL SITE SKETCH

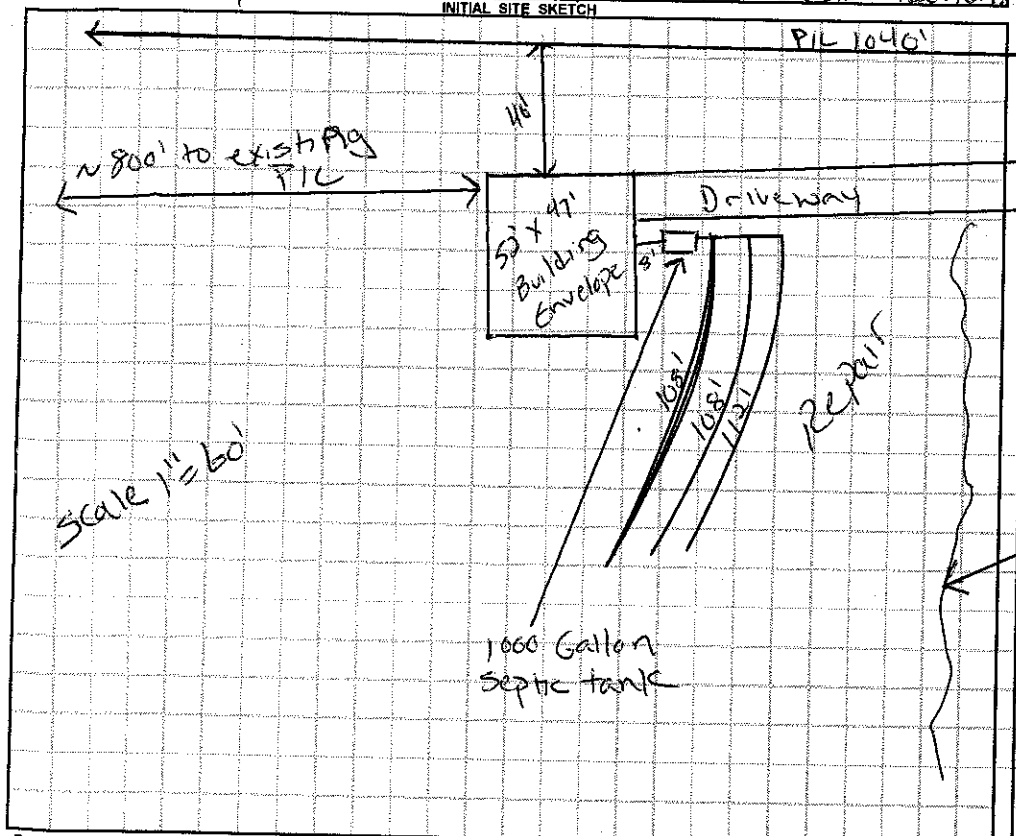


AS BUILT SKETCH

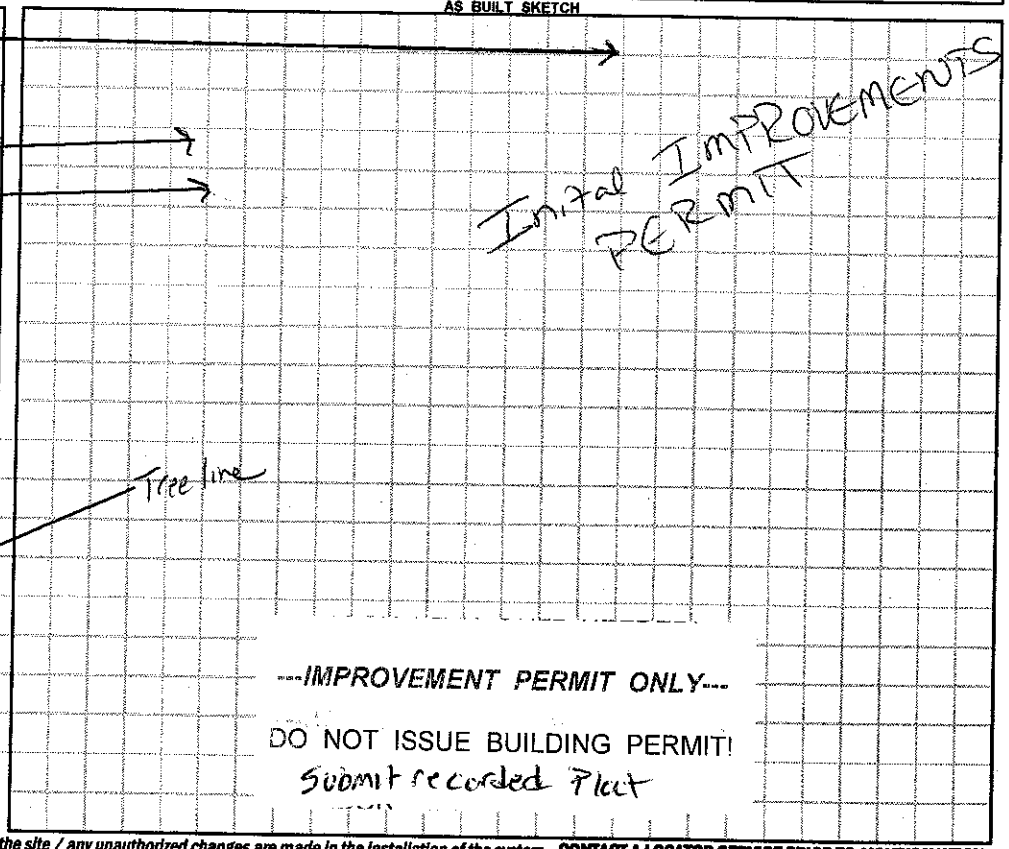


*Permit can be suspended or revoked if any false information is supplied toward securing the permit / any unauthorized changes are made to the site / any unauthorized changes are made in the installation of the system.* **CONTACT A LOCATOR SERVICE PRIOR TO ANY EXCAVATION**

☐ **IMPROVEMENT PERMIT** *with plat valid without expiration.* ☑ **IMPROVEMENT PERMIT** *with site plan valid for 60 mos.* ☐ **AUTHORIZATION TO CONSTRUCT** *valid for period equal to IMPROVEMENT PERMIT--not to exceed 60 mo.*

Owner / Applicant Signature: Jason L Shumaker Date: 5/7/14 Installed by:

IMPROVEMENT PERMIT by: Justin Henderson Date: 5-6-14 OPERATION PERMIT by: Date:

AUTHORIZATION TO CONSTRUCT by: Date: Existing System Inspected by: Date:

Health Dept. Copy - WHITE Applicant (Final Approval) - YELLOW Applicant (Conditional Approval) - PINK