IREDELL COUNTY HEALTH DEPARTMENT

STATESVILLE 704-878-5305 MOORESVILLE 704-664-5281

IMPROVEMENT PERMIT / AUTHORIZATION TO CONSTRUCT / OPERATION PERMIT / EXISTING SYSTEM INSPECTION

PERMIT# 117869 PIN# 4832-72-4508 DATE 3-17-04

OWNER OR CONTRACTOR DAN & SUSAN WILLIAMS PHONE: Business (704) 902-3786 - (KENNY MADISON) Home

ADDRESS 716 EARLY DR. HARTWELL, GA 30643

LOCATION 21 N (L) JENNINGS (L) TRUMPET BRANCH ON CORNER OF GOFORTH AND TRUMPET BRANCH ON (L)

SUBDIVISION BLOCK / SECTION LOT LOT AREA 54.2 SITE CLASS. PS DESIGN FLOW 360 L.T.A.R. .3 GPD/FT²

Septic Tank: 1000 Gallons; STB 794 Date 2-12-04
Pump Tank: Gallons; PT Date
Pump Make: Model Serial No.
Nitrification Field: No Fields 1 Square Feet 1200 Linear Feet 400
No Lines 5 Trench Width 36" Max Trench Bottom Depth 24" Gravel Depth 12"

☑ New System ☐ Repair System Type: I, (II) III, IV, V, VI
System Description: CONVENTIONAL GRAVITY
Repair System Description: GRAVITY 25% RED
Maintenance Agreement Required: ☐ Yes ☑ No


☑ House/Mod. Home No. Bedrooms 3
☐ Mobile Home No. Bathrooms 2.5
☐ Business No. Employees
☐ Other
☐ Slab ☐ Crawl Space ☑ Basement w/plumbing ☐ Basement wo/plumbing

Water Supply: ☐ Individual ☑ Public ☐ Community


Comments:/Conditions: (1) MAINTAIN SETBACKS (2) INSTALL LINES 24" ON CONTOUR (3) INSTALL SUPPLY LINE TO AVOID DAMAGING BLACK WALNUT TREE

Comments:/Conditions: (1) ZABEL FILTER (2) FLOW-DIVIDER LEVEL (3) #5 STONE

INITIAL SITE SKETCH SCALE 1" = 100'

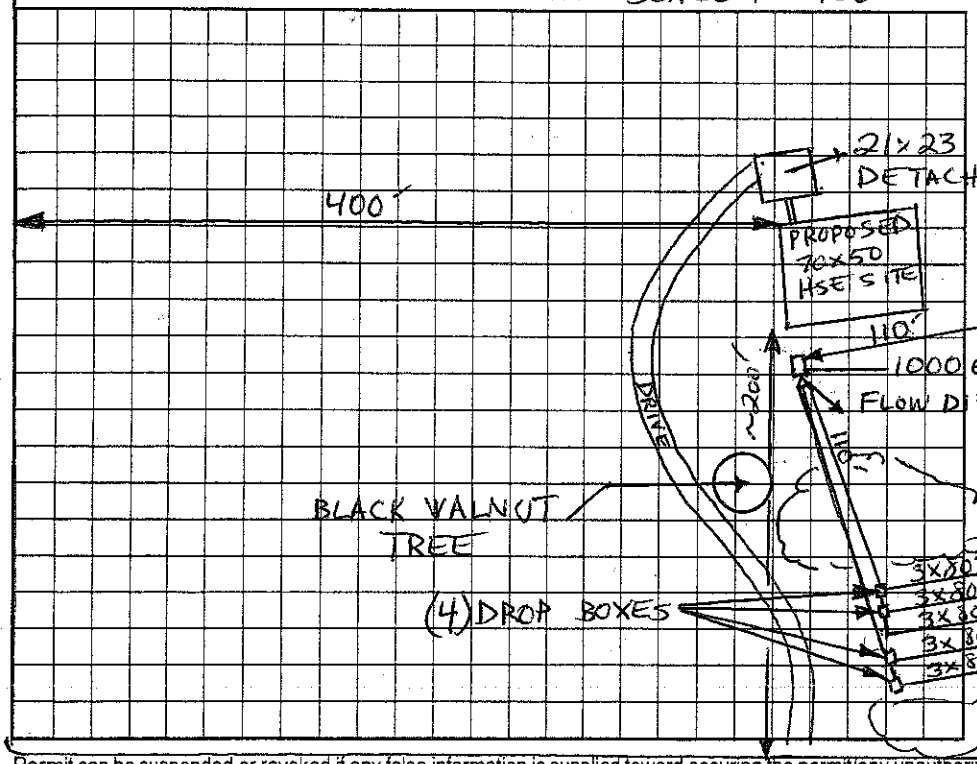

AS BUILT SKETCH

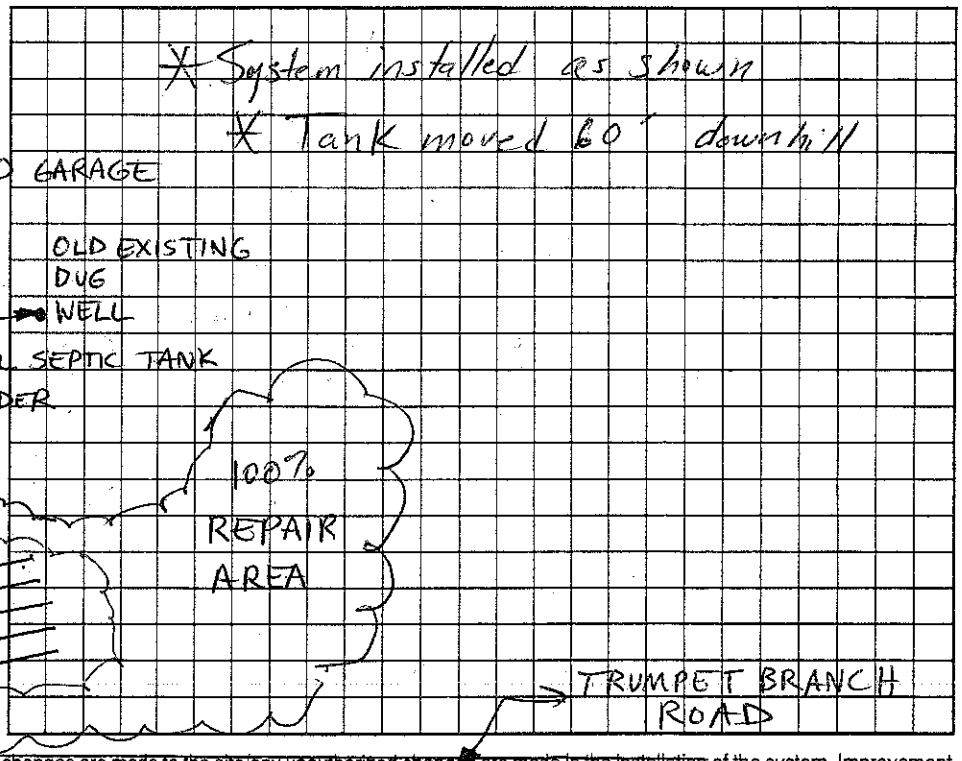

Permit can be suspended or revoked if any false information is supplied toward securing the permit/any unauthorized changes are made to the site/any unauthorized changes are made in the installation of the system. Improvement Permit with plat valid without expiration. Improvement Permit with site plan valid for sixty months. Authorization to Construct is valid for a period equal to that of Improvement Permit – not to exceed sixty months.

Signed: Kenny Madison date 3-22-04 Installed by: Kenny Madison

Improvement Permit by: Christopher M. Sheild, RS date 3-17-04 Operation Permit by: Christopher M. Sheild, RS date 3-25-04

Authorization to Construct by: Christopher M. Sheild, RS date 3-17-04 Existing System Inspection by: date

HEALTH DEPT. COPY: WHITE OWNER COPY (FINAL): YELLOW OWNER COPY (INITIAL): PINK