IREDELL COUNTY HEALTH DEPARTMENT

STATESVILLE 704-878-5305 MOORESVILLE 704-664-5281

55596

IMPROVEMENT PERMIT / CERTIFICATE OF COMPLETION / OPERATION PERMIT / EXISTING SYSTEM INSPECTION

PROPERTY DESCRIPTION NO. 20869 DATE 4/18/95 TAX MAP NO. 16F-A-2 Watershed: ☐ Yes ☒ No

OWNER OR CONTRACTOR ARNOLD JAMES HENDRIX PHONE: Business _____ Home 539-5295

ADDRESS P.O Box 94, UNION GROVE NC 28689

LOCATION U321 N, TL JENNINGS, TL TRUMPET BRANCH, LOT ON (R) JUST PAST GOFORTH RD

SUBDIVISION _____ BLOCK / SECTION _____ LOT _____ LOT AREA 13.34 Ac SITE CLASS. PS DESIGN FLOW 360 L.T.A.R. 0.35 GAD/FT2

Septic Tank: 1000 Gallons; STB 794 Date 7-18-95

Pump Tank: — Gallons; PT — Date —

Pump Make: — Model — Serial No. —

Nitrification Field: No Fields 1 Square Feet 1035 Linear Feet 345

No Lines 3 4 Trench Width 36" Max Trench Bottom Depth 28-30 Gravel Depth 12"

☒ New System ☐ Repair System Type: I, II, III, IV, V, VI

System Description: CONVENTIONAL GRAVITY

Repair System Description: CONV. GRAVITY

Maintenance Agreement Required: ☐ Yes ☒ No

☒ House/Mod. Home No. Bedrooms 3

☐ Mobile Home No. Bathrooms 2

☐ Business No. Employees _____

☐ Other: _____


☐ Slab ☐ Crawl Space ☐ Basement w/plumbing ☒ Basement wo/plumbing

Water Supply: ☒ Individual ☐ Community ☐ Public WELL

Comments: ① KEEP WELL MINIMUM 100' FROM SYSTEM ② KEEP SYSTEM MINIMUM 20' FROM BASEMENT FOUNDATION DRAIN ③ INSTALL LINES NO DEEPER THAN 30", ON CONTOUR

Comments: REVISED 9-21-95 DUE TO U.S. CUT-FACE AT FRONT OF LOT. Septic Tank inspected by Steve Hedrick.

INITIAL SITE SKETCH

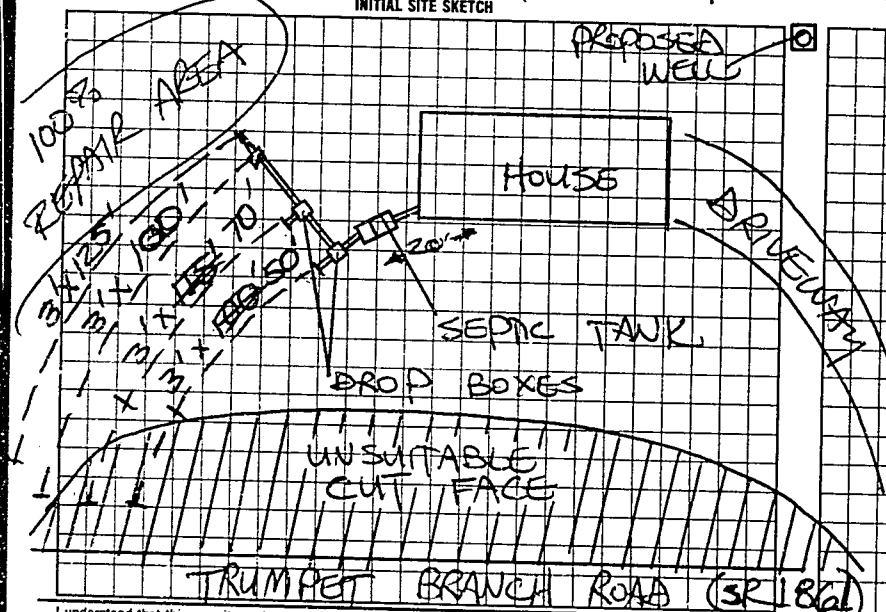

AS BUILT SKETCH

Well located at time of inspection. It is 100'+ to closest part of septic system.

SAME AS INITIAL SKETCH

I understand that this permit can be suspended or revoked if any false information is supplied toward securing the permit/any unauthorized changes are made to the site/any unauthorized changes are made in the installation of the system. Improvement Permit is valid for 60 months from date of issuance.

Signed: X Edward Shumaker

Improvement Permit by: STEVE HEDRICK date 4/18/95

Existing System Inspection by: _____ date _____

Installed by: A-1 Backhoe

Certificate of Completion by: Michael J. Dennis date 9-27-95

Operation Permit by: _____ date _____

HEALTH DEPT. COPY: WHITE INSPECTION COPY (FINAL): GREEN OWNER COPY (FINAL): YELLOW INSPECTION COPY (INITIAL): PINK OWNER COPY (INITIAL): GOLD