CI

IREDELL COUNTY HEALTH DEPARTMENT

STATESVILLE 704-878-5305 MOORESVILLE 704-664-5281

IMPROVEMENT PERMIT / AUTHORIZATION TO CONSTRUCT / OPERATION PERMIT / EXISTING SYSTEM INSPECTION

PERMIT# 142907 PIN# ~~4832-74-8180~~ 7385 91 DATE 6-4-2007

OWNER OR APPLICANT RELDA HANELINE PHONE: Business 704-872-9786 Home 704-450-8275

ADDRESS 210 DUCK CREEK ROAD, TROUTMAN, NC 28166

LOCATION JENNINGS ROAD TO TRUMPET BRANCH ROAD, 1.5 MILE ON RIGHT

SUBDIVISION _____ BLOCK / SECTION _____ LOT _____ LOT AREA 30 ACRES SITE CLASS. PS DESIGN FLOW 480 L.T.A.R. 0.30 GAD/FT²

Septic Tank: 1000 Gallons; STB 1012 Date 2-12-07
Pump Tank: _____ Gallons; PT _____ Date _____
Pump Make: _____ Model _____ Serial No. _____
Nitrification Field: No Fields 1 Square Feet 1600 Linear Feet ~~540~~ 400
No Lines ~~FIVE~~ 4 Trench Width 36" Max Trench Bottom Depth 30"

☑ New System ☐ Repair ☐ Expansion ☐ System Type: I II III IV V VI
System Description: CONVENTIONAL GRAVITY
Repair System Description: CONVENTIONAL, GRAVITY
Maintenance Agreement Required: ☐ Yes ☑ No
Gravel Depth 12" ☑ Gravity ☐ Pressure

☑ House/Mod. Home No. Bedrooms 4
☐ Mobile Home No. Persons ____
☐ Business No. Employees ____
☐ Other ____


Water Supply: ☐ Individual ☑ Public ☐ Community

☐ Slab ☑ Crawl Space ☐ Basement w/plumbing ☐ Basement wo/plumbing


Comments/Conditions: ① INSTALL LINES ON CONTOUR AS SHOWN.
② AN "ACCEPTED" SYSTEM MAY ALSO BE USED
~SCALE: 1" = 40'

Comments/Conditions: SEPTIC TANK W/ MARKER INSTALLED USING "TUFTITE" FILTER

INITIAL SITE SKETCH

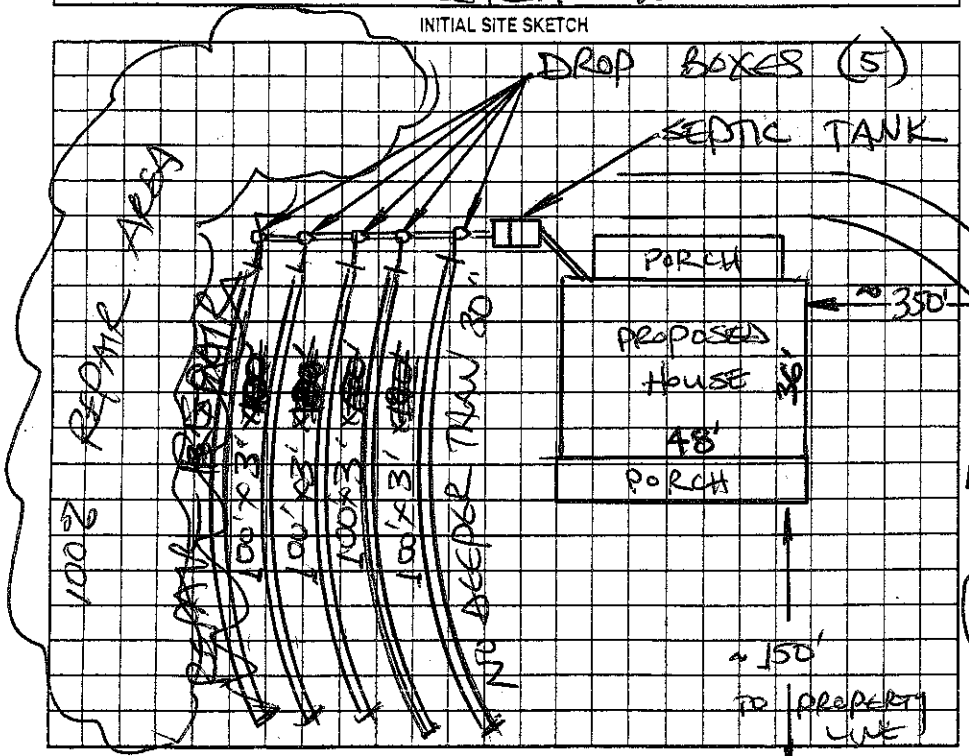

AS BUILT SKETCH

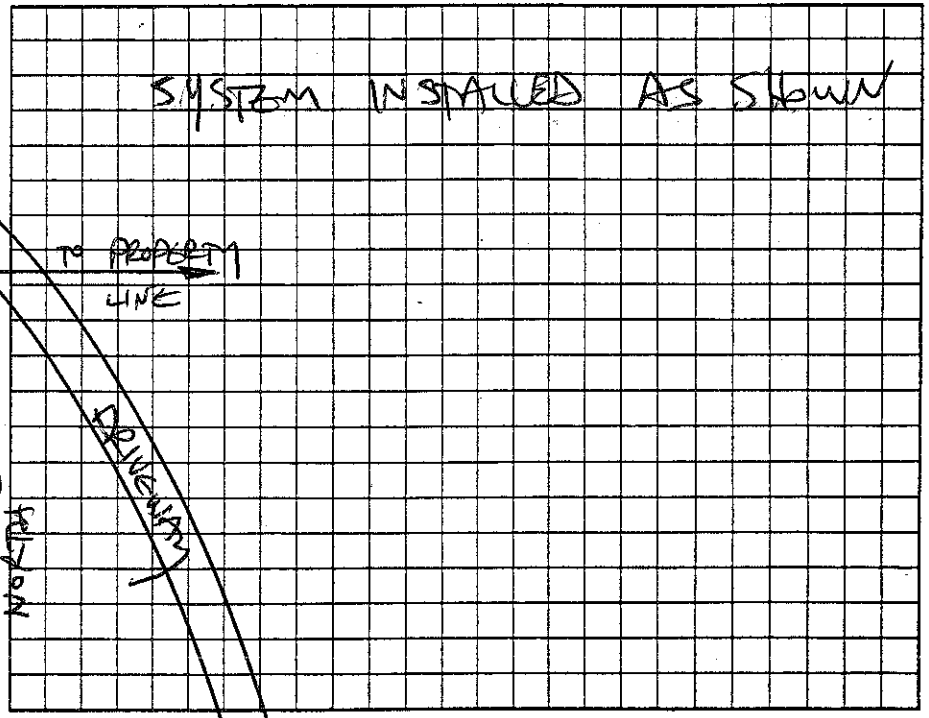

Permit can be suspended or revoked if any false information is supplied toward securing the permit/any unauthorized changes are made to the site/any unauthorized changes are made in the installation of the system. Improvement Permit with plat valid without expiration ☐ Improvement Permit with site plan valid for sixty months ☐ Authorization to Construct is valid for a period equal to that of Improvement Permit – not to exceed sixty months.

Signed: _____ date 6-4-07 Installed by: A-1 BACKHOE

Improvement Permit by: STEVE HEDRICK date 6-4-2007 Operation Permit by: STEVE HEDRICK date 7-11-07

Authorization to Construct by: STEVE HEDRICK date 6-4-2007 Existing System Inspection by: _____ date _____

HEALTH DEPT. COPY: WHITE OWNER COPY (FINAL): YELLOW OWNER COPY (INITIAL): PINK