55061

IREDELL COUNTY HEALTH DEPARTMENT

STATESVILLE 704-878-5305 MOORESVILLE 704-664-5281

IMPROVEMENT PERMIT / CERTIFICATE OF COMPLETION / OPERATION PERMIT / EXISTING SYSTEM INSPECTION

PROPERTY DESCRIPTION NO. 20406 DATE 3/2/95 TAX MAP NO. 16G-A-48 (PART OF) Watershed: ☐ Yes ☒ No

OWNER OR CONTRACTOR C. DALE MOORE PHONE: Business Home 592-2225

ADDRESS P.O. BOX 6735 STATESVILLE NC 28677

LOCATION US 21 N, TL JENNINGS, TL TRUMPET BRANCH, ON RIGHT ACROSS FROM GODFREY ROAD

SUBDIVISION BLOCK / SECTION LOT LOT AREA ~30 AC SITE CLASS. PS DESIGN FLOW 360 L.T.A.R. 0.35GPA/FT2

Septic Tank: 1000 Gallons; STB 854 Date 2-22-95
Pump Tank: Gallons; PT Date
Pump Make: Model Serial No
Nitrification Field: No Fields 1 Square Feet 1035 Linear Feet 345
No Lines 3 Trench Width 36" Max Trench Bottom Depth 18-36" Gravel Depth 12"

☑ New System ☐ Repair System Type: I (II), III, IV, V, VI
System Description: CONVENTIONAL GRAVITY
Repair System Description: CONV. GRAVITY
Maintenance Agreement Required: ☐ Yes ☒ No


☐ House/Mod. Home ☒ Mobile Home ☐ Business ☐ Other
No. Bedrooms 3 No. Bathrooms 2 No. Employees
☐ Slab ☑ Crawl Space ☐ Basement w/plumbing ☐ Basement wo/plumbing

Water Supply: ☑ Individual ☐ Community ☐ Public WELL

Comments: ① KEEP SYSTEM MINIMUM 5' FROM MH, 10' FROM PROPERTY LINE, 100' FROM WELL
② INSTALL LINES ON CONTOUR, NO DEEPER THAN 36", 9' MINIMUM ON CENTER

Comments: 2nd line goes up hill 1'. Soil appears to be mostly saprolite and weathered Rock. Appears that soil has been cut off over area where system is to be installed or is installed.

INITIAL SITE SKETCH

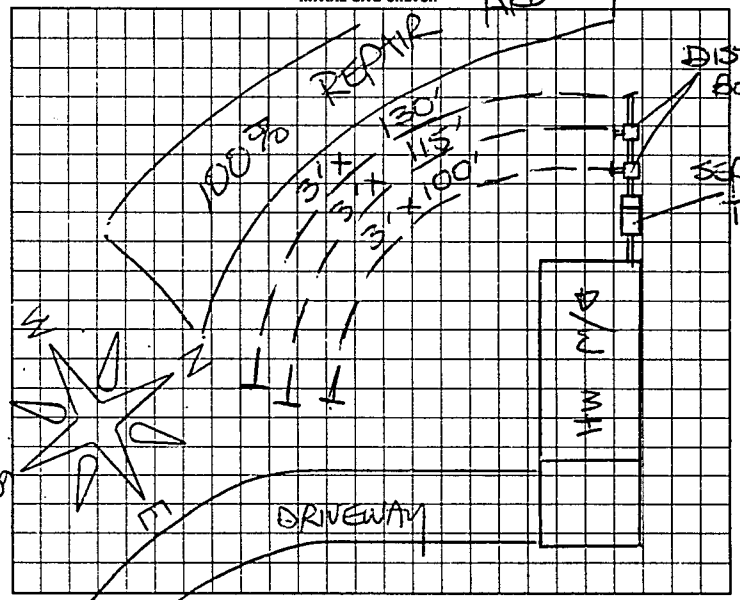

AS BUILT SKETCH

ADDITIONAL STONE ADDED TO 1ST & 2ND TRENCH IN EFFORT TO BRING SYSTEM INTO COMPLIANCE. SYSTEM INSTALLED TO MEET MINIMUM REQUIREMENTS.

I understand that this permit can be suspended or revoked if any false information is supplied toward securing the permit/any unauthorized changes are made to the site/any unauthorized changes are made in the installation of the system. Improvement Permit is valid for 60 months from date of issuance.

Signed: X Dale Moore

Improvement Permit by: STEVE HEDRICK date 3/2/95

Existing System Inspection by date

Installed by: JUNIOR HARNESS, KENNY PEARSON

Certificate of Completion by: STEVE HEDRICK date 4/26/95

Operation Permit by: date

HEALTH DEPT. COPY: WHITE INSPECTION COPY (FINAL): GREEN OWNER COPY (FINAL): YELLOW INSPECTION COPY (INITIAL): PINK OWNER COPY (INITIAL): GOLD

5 1 1 0 0