IREDELL COUNTY HEALTH DEPARTMENT

Statesville Phone TR 3-7271 Mooresville Phone

PERMIT TO INSTALL SEPTIC TANK

Permit No. 214 Permit Date 5 MAR 1973

Owner Hugh S. Beaver Address Olin

Installed By Roy Lentz Address Statesville


Location of Property N on Jennings Rd to # 1861. Turn Left 1½ mile to Rd # 1858. Turn Right first private drive on Left.

Tank		Capacity		Length of Lines		Fixtures	
Block	( )	1000	(✓)	225'	(✓)	No. of Baths	(2)
Precast	(✓)	1250	( )	250'	( )	Dishwasher	( )
		1500	( )	Other		Garbage Grdr.	( )
		Other				Other	

NOTIFY HEALTH DEPARTMENT AT LEAST EIGHT HOURS BEFORE TANK IS TO BE INSPECTED.

Final Inspection 5 MAR 1973 Approved (✓) Disapproved ( )

Remarks

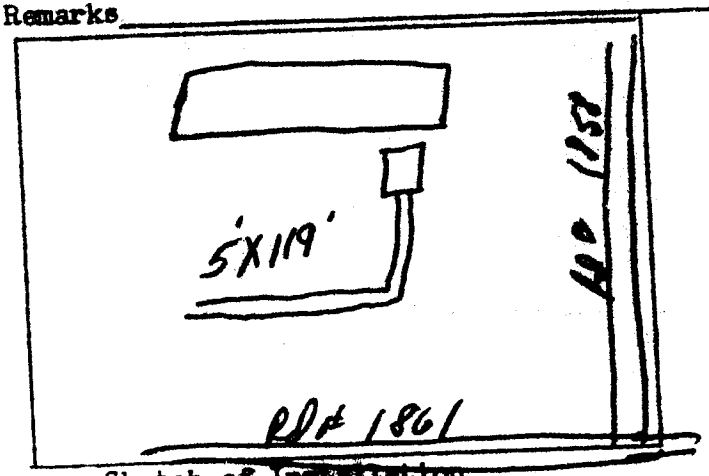

Sketch of Installation

William M. Howard
Sanitarian