IREDELL COUNTY HEALTH DEPARTMENT

STATESVILLE 704-878-5305 MOORESVILLE 704-664-5281

IMPROVEMENT PERMIT / CERTIFICATE OF COMPLETION / OPERATION PERMIT / EXISTING SYSTEM INSPECTION

PROPERTY DESCRIPTION NO. 25073 CC6021 DATE 10-9-96 TAX MAP NO. PART OF 16G-A-125 Watershed: ☐ Yes ☑ No

OWNER OR CONTRACTOR RICKY D. HONEYCUTT PHONE: Business Home (704) 875-1291

ADDRESS 10039 HAGERS RD HUNTERSVILLE, NC 28078

LOCATION US 21 N, TL JENNINGS, TL EXPEDITE SPRINGS, LOT ON RIGHT JUST BEFORE TRUMPET BRANCH

SUBDIVISION BLOCK / SECTION LOT LOT AREA ~20 ACRES SITE CLASS. PS DESIGN FLOW 360 L.T.A.R. 0.30 GPD/FT²

Septic Tank: 1000 Gallons; STB 1012 Date 5-28-97
Pump Tank: Gallons; PT Date
Pump Make: Model Serial No.
Nitrification Field: No Fields 1 Square Feet 1200 Linear Feet 400
No Lines FOUR Trench Width 36" Max Trench Bottom Depth 30" Gravel Depth 12"

☑ New System ☐ Repair System Type: I, II, III, IV, V, VI
System Description: CONVENTIONAL GRAVITY
Repair System Description: CONV. PUMP/GRAVITY
Maintenance Agreement Required: ☐ Yes ☑ No


☑ House/Mod. Home No. Bedrooms 3
☐ Mobile Home No. Bathrooms 3
☐ Business No. Employees
☑ Other
☐ Slab ☐ Crawl Space ☑ Basement w/plumbing ☐ Basement wo/plumbing

Water Supply:
☑ Individual
☐ Community
☐ Public
WELL

Comments: ① USE SEWAGE PUMP IN BASEMENT TO LIFT SEWAGE TO 1ST FLOOR ELEVATION ② USE THREE FLOW DIVIDER TEES TO ACHIEVE EQUAL DISTRIBUTION INTO FOUR LINES ③ KEEP SYSTEM MINIMUM 100' FROM WELL.

Comments:

INITIAL SITE SKETCH

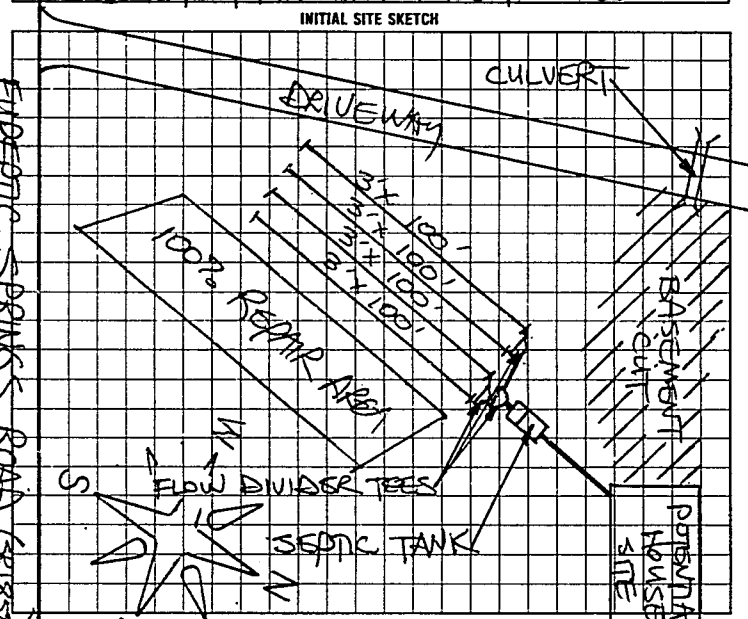

AS BUILT SKETCH

SAME

I understand that this permit can be suspended or revoked if any false information is supplied toward securing the permit/any unauthorized changes are made to the site/any unauthorized changes are made in the installation of the system.

AUTH. TO CONST. IS VALID FOR A PERIOD EQUAL TO THE VALIDITY OF THE I.P. NOT TO EXCEED FIVE YEARS. I.P. WITH SITE PLAN IS VALID FIVE YEARS.

Signed: [signature]

Installed by: KENNY MADISON

Improvement Permit by: STEVE HEDRICK date 10-9-96

AUTH. TO CONSTRUCT

Certificate of Completion by: date

Operation Permit by: STEVE HEDRICK date 8-7-97

HEALTH DEPT. COPY: WHITE INSPECTION COPY (FINAL): GREEN OWNER COPY (FINAL): YELLOW INSPECTION COPY (INITIAL): PINK OWNER COPY (INITIAL): GOLD