IREDELL COUNTY HEALTH DEPARTMENT

Statesville Office (704) 878-5305 Mooresville Office (704) 660-3625 PERMIT # 21612

IMPROVEMENT PERMIT / AUTHORIZATION TO CONSTRUCT / OPERATION PERMIT / EXISTING SYSTEM

PIN # 4832924433

APPLICANT: James Stanley APPLICANT ADDRESS: 405 Trumpet Branch Rd.

SITE ADDRESS: 409 Trumpet Branch Rd. PHONE: 704-450-8495 ALT. PHONE: 704-682-4184

SITE DIRECTIONS: Hwy 21N TL Jennings Rd. TL Trumpet Branch Rd.

SUBDIVISION: Chipley Ford Dairy Farm SECTION: 1 LOT # 8 LOT AREA: 3.90 acres DESIGN FLOW: 360gpd L.T.A.R.: 0.25

Septic Tank 1000 (gal) STB Date

Pump Tank (gal) PT Date

Pump Make Model Serial #

Nitrification Fields 1 # Lines 4 Linear Ft: 360

Trench Width 36" Max. Trench Bottom Depth 30" Gravel Depth N/A

☑ New System ☐ Repair ☐ Expansion System Type: I II (III) IV V VI

System Description: 25% Reduction

Repair System Description: DRIP

Maintenance Agreement Required: ☐ YES ☑ NO

☑ GRAVITY ☐ PRESSURE

☑ Residence No. Bedrooms 3

☐ Business No. Persons 6

☐ Other No. Employees

☐ Slab ☐ Crawl Space


☐ Basement w/plumbing ☑ Basement w/o plumbing

Water Supply: ☑ Private ☐ Public ☐ Community


Comments / Conditions: IMPROVEMENTS ONLY! Record Proposed Lot lines prior to issuance of CA! Install a 25% Reduction system on contour with serial distribution.

Install trench bottoms @ 30" on high side.

INITIAL SITE SKETCH

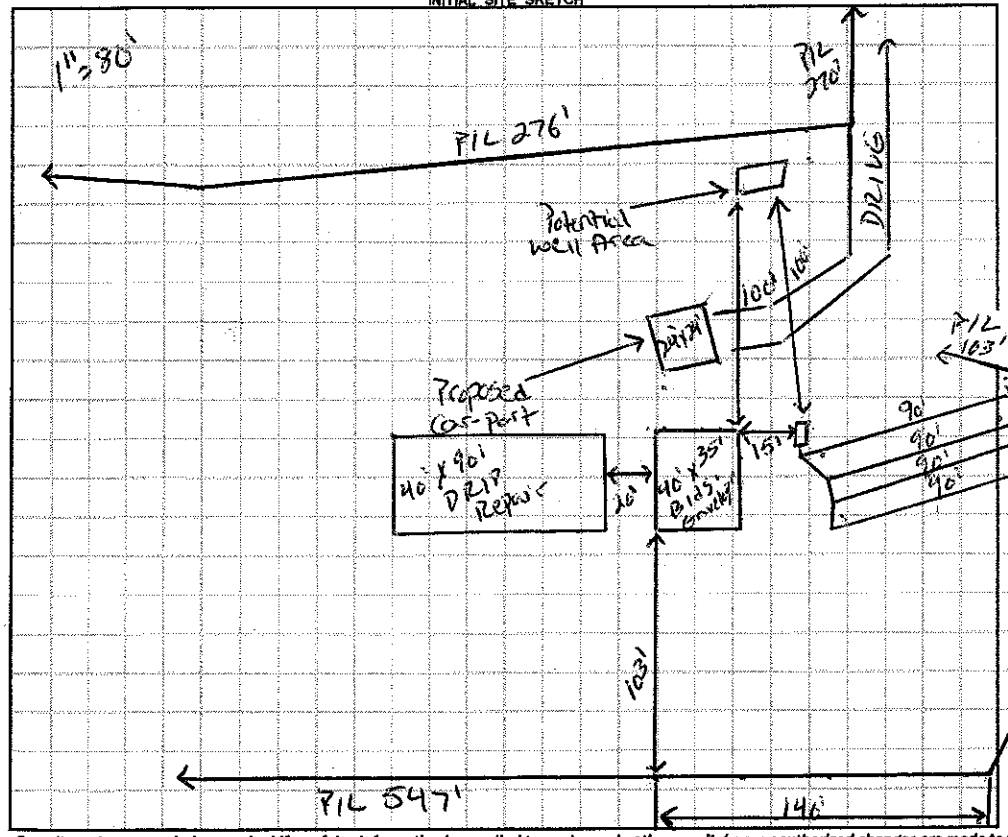

AS BUILT SKETCH

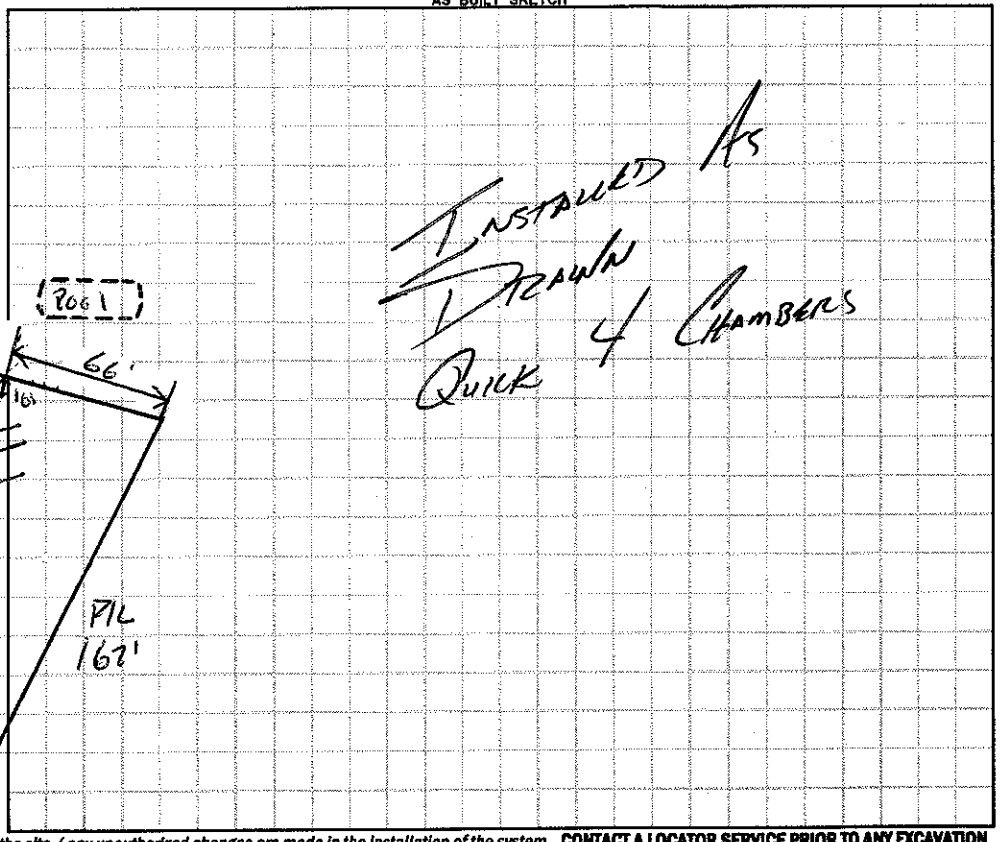

Permit can be suspended or revoked if any false information is supplied toward securing the permit / any unauthorized changes are made to the site / any unauthorized changes are made in the installation of the system. **CONTACT A LOCATOR SERVICE PRIOR TO ANY EXCAVATION**

☐ **IMPROVEMENT PERMIT** *with plat valid without expiration.* ☑ **IMPROVEMENT PERMIT** *with site plan valid for 60 mos.* ☑ **AUTHORIZATION TO CONSTRUCT** *valid for period equal to IMPROVEMENT PERMIT--not to exceed 60 mo.*

Owner / Applicant Signature: Date: 4-15-16 Installed by: Al Backhoe

IMPROVEMENT PERMIT by: Justin Henderson Date: 3-18-16 OPERATION PERMIT by: Date: 8/8/16

AUTHORIZATION TO CONSTRUCT by: Justin Henderson Date: 4-15-16 Existing System Inspected by: Date:

Health Dept. Copy - WHITE Applicant (Final Approval) - YELLOW Applicant (Conditional Approval) - PINK