IREDELL COUNTY HEALTH DEPARTMENT

STATESVILLE 704-878-5305 MOORESVILLE 704-664-5281

IMPROVEMENT PERMIT / AUTHORIZATION TO CONSTRUCT / OPERATION PERMIT / EXISTING SYSTEM INSPECTION

PERMIT# 089393 PIN# 4832959343 DATE 8-15-00

OWNER OR CONTRACTOR COREY SPEECE PHONE: Business Home 539-5279

ADDRESS 126 GURNEY ROAD OLIN NC 28660

LOCATION US 21 N, TL JENNINGS RD, TL EUPEPTIC SPRINGS RD, TR GURNEY RD, 0.3 MILE ON LEFT

SUBDIVISION BLOCK / SECTION LOT LOT AREA 13.66 ACRES SITE CLASS PS DESIGN FLOW 360 L.T.A.R. 0.30 GPD/FT²

Septic Tank: 1000 Gallons: STB 312 Date 2-29-00
Pump Tank: Gallons: PT Date
Pump Make: Model Serial No.
Nitrification Field: No Fields 1 Square Feet 1200 Linear Feet 400
No Lines FOUR Trench Width 36" Max Trench Bottom Depth 36" Gravel Depth 12"

☑ New System ☐ Repair System Type: I II III IV V VI
System Description: CONVENTIONAL GRAVITY
Repair System Description: CONV. GRAVITY
Maintenance Agreement Required: ☐ Yes ☑ No

☑ House/Mod. Home No. Bedrooms 3
☑ Mobile Home No. Bathrooms 2
☐ Business No. Employees
☐ Other
☐ Slab ☑ Crawl Space ☐ Basement w/plumbing ☐ Basement wo/plumbing


Water Supply: ☑ Individual ☐ Public ☐ Community WELL

Comments:/Conditions: S/W MH TO BE REMOVED UPON OCCUPANCY OF HOUSE

Comments:/Conditions: SEPTIC TANK WITH MARKER INSTALLED USING "BABCL" FILTER

SCALE: 1" = 40'

INITIAL SITE SKETCH

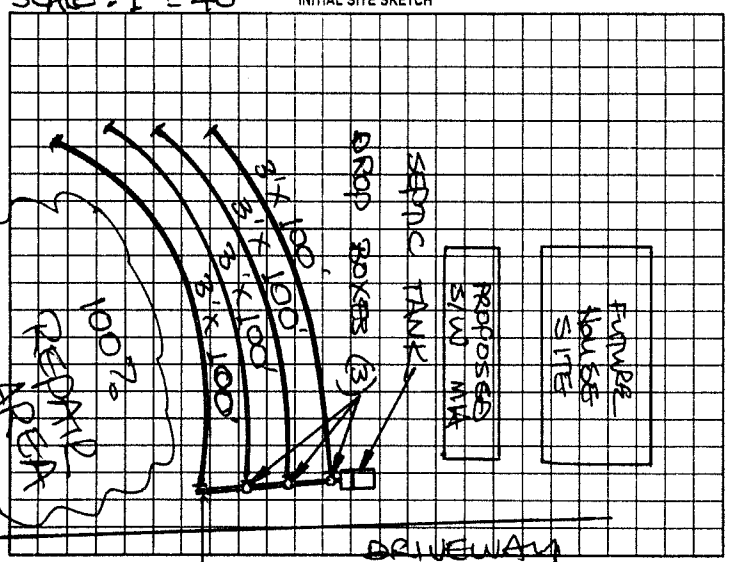

AS BUILT SKETCH

S/W SYSTEM INSTALLED ACCORDING TO INITAL SITE SKETCH

Permit can be suspended or revoked if any false information is supplied toward securing the permit/any unauthorized changes are made to the site/any unauthorized changes are made in the installation of the system. Improvement Permit with plat valid without expiration. Improvement Permit with site plan valid for sixty months. Authorization to Construct is valid for a period equal to that of Improvement Permit – not to exceed sixty months.

Signed: Corey Speece date 8-15-00 Installed by: COREY SPEECE

Improvement Permit by: STEVE HEDRICK date 8-15-00 Operation Permit by: STEVE HEDRICK date 10-16-00

Authorization to Construct by: STEVE HEDRICK date 8-15-00 Existing System Inspection by: date

HEALTH DEPT. COPY: WHITE OWNER COPY (FINAL): YELLOW OWNER COPY (INITIAL): PINK