IREDELL COUNTY HEALTH DEPARTMENT

STATESVILLE 704-878-5305 MOORESVILLE 704-664-5281

IMPROVEMENT PERMIT / AUTHORIZATION TO CONSTRUCT / OPERATION PERMIT / EXISTING SYSTEM INSPECTION

PERMIT# REPAIR PIN# 4833-16-7305 DATE 3-19-04

OWNER OR CONTRACTOR THOMAS C. SOUTHER PHONE: Business Home (704) 592-5408

ADDRESS 2753 W. MEMORIAL HWY OLIN, NC 28660

LOCATION I-77N EXIT 65 (L) 901 PROPERTY ON (L) BEFORE SOUTHER DAIRY FARM

SUBDIVISION BLOCK / SECTION LOT LOT AREA 1.04 SITE CLASS. PS DESIGN FLOW 360 L.T.A.R. EXISTING

Septic Tank: EXISTING Gallons; STB Date

Pump Tank: Gallons; PT Date

Pump Make: Model Serial No.

Nitrification Field; No Fields 1 Square Feet 1200 Linear Feet 400

No Lines 4 Trench Width 36" Max Trench Bottom Depth 24" Gravel Depth 12"

☐ New System ☑ Repair System Type: I (II) III, IV, V, VI

System Description:

Repair System Description: CONVENTIONAL GRAVITY

Maintenance Agreement Required: ☐ Yes ☑ No

☑ House/Mod. Home No. Bedrooms 3

☐ Mobile Home No. Bathrooms 1

☐ Business No. Employees

☐ Other

☐ Slab ☑ Crawl Space ☐ Basement w/plumbing ☐ Basement wo/plumbing


Water Supply: ☐ Individual ☐ Public ☑ Community WELL

Comments/Conditions: (1) INSTALL LINES 24" ON CONTOUR (2) DISCONNECT OLD SEPTIC LINES

Comments/Conditions: * (1) #5 STONE (2) D-BOX USED INSTEAD OF FLOW SPLITTER (3) TEE INSTALLED IN TANK

SCALE 1" = 60'

INITIAL SITE SKETCH

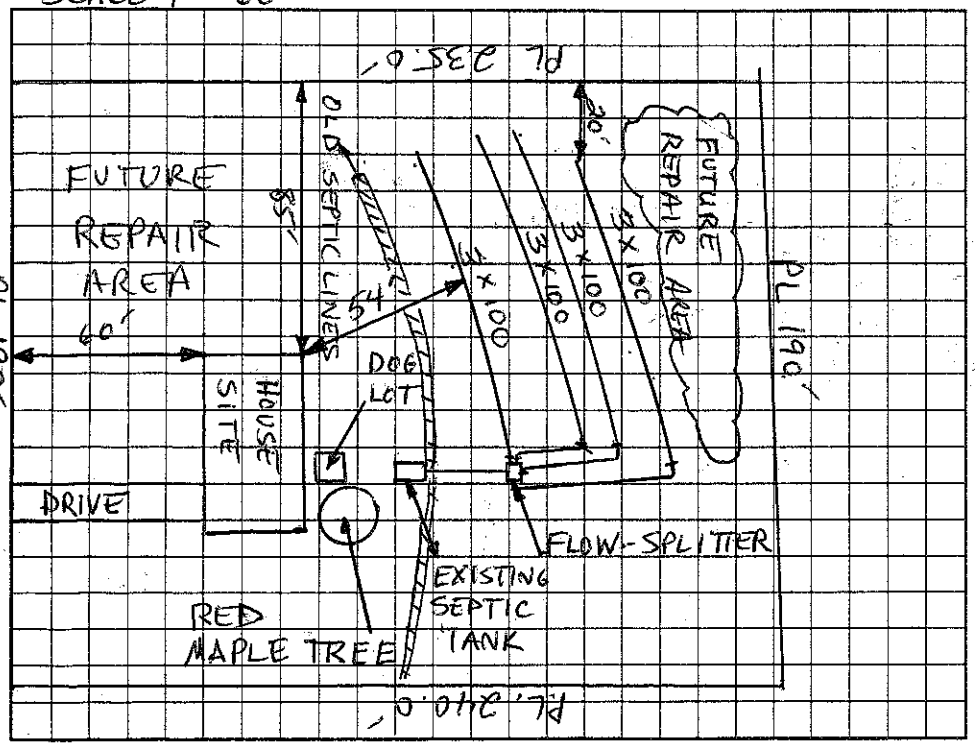

AS BUILT SKETCH

* Installed as shown

Permit can be suspended or revoked if any false information is supplied toward securing the permit/any unauthorized changes are made to the site/any unauthorized changes are made in the installation of the system. Improvement Permit with plat valid without expiration. Improvement ~~Permit with site plan~~ valid for sixty months. Authorization to Construct is valid for a period equal to that of Improvement Permit – not to exceed sixty months.

Signed: Thomas C Souther date 3-22-04 Installed by: Umbarger Backhoe

Improvement Permit by: Christopher M. Sherrill, RS date 3-19-04 Operation Permit by: Christopher M Sherrill, RS date 4-21-04

Authorization to Construct by: Christopher M. Sherrill, RS date 3-19-04 Existing System Inspection by: date

HEALTH DEPT. COPY: WHITE OWNER COPY (FINAL): YELLOW OWNER COPY (INITIAL): PINK