IREDELL COUNTY HEALTH DEPARTMENT

STATESVILLE 704-878-5305 MOORESVILLE 704-664-5281

IMPROVEMENT PERMIT / AUTHORIZATION TO CONSTRUCT / OPERATION PERMIT / EXISTING SYSTEM INSPECTION

PERMIT# 104214 PIN# 4833 28 2223 2154 DATE 1-28-02

OWNER OR CONTRACTOR ROBIN BELL PHONE: Business Home 704-394-4719

ADDRESS 5936 MT. HOLLY - HUNTERSVILLE RD, CHARLOTTE, NC 28216

LOCATION I-77 NORTH, TL NC 901, TR GRASSY KNOB ROAD, 0.2 MILE ON RIGHT, BACK OFF ROAD

SUBDIVISION BLOCK / SECTION LOT LOT AREA 51.9 ACRES SITE CLASS. PS DESIGN FLOW 480 L.T.A.R. 0.30 GPD/FT²

Septic Tank: 1000 Gallons; STB 1012 Date 1-10-03

Pump Tank: Gallons; PT Date

Pump Make: Model Serial No.

Nitrification Field: No Fields 1 Square Feet 1600 Linear Feet 540

No Lines SIX Trench Width 36" Max Trench Bottom Depth 36" Gravel Depth 12"

☑ New System ☐ Repair System Type: I, II, III, IV, V, VI

System Description: CONVENTIONAL GRAVITY

Repair System Description: CONVENTIONAL GRAVITY

Maintenance Agreement Required: ☐ Yes ☑ No

☑ House/Mod. Home No. Bedrooms 4

☐ Mobile Home No. Bathrooms 4.5

☐ Business No. Employees

☐ Other

☐ Slab ☐ Crawl Space ☑ Basement w/plumbing ☐ Basement wo/plumbing


Water Supply: ☑ Individual ☐ Public ☐ Community WELL

Comments:/Conditions: ① KEEP SYSTEM MINIMUM 100 FEET FROM WELL ② INSTALL SUBSURFACE INTERCEPT DRAINAGE DITCH AT LOCATION SHOWN ③ USE ONE FLOW DIVIDER TEE TO ACHIEVE EQUAL DISTRIBUTION INTO TWO SERIES OF DROP BOXES


Comments:/Conditions:


INITIAL SITE SKETCH

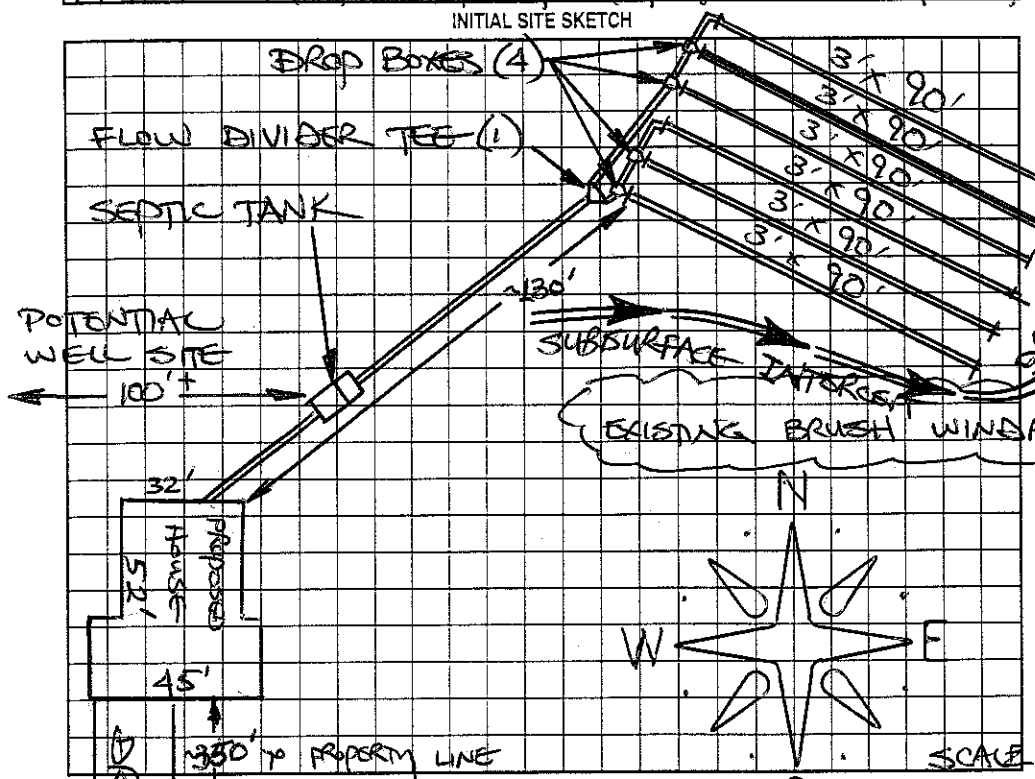

AS BUILT SKETCH

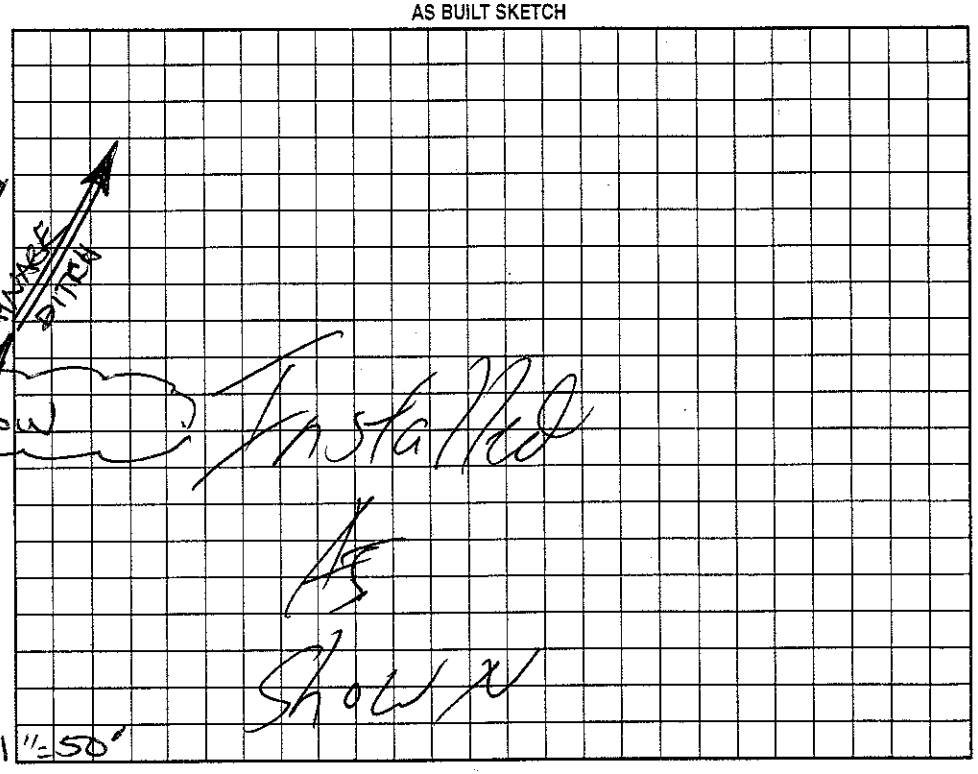

Permit can be suspended or revoked if any false information is supplied toward securing the permit/any unauthorized changes are made to the site/any unauthorized changes are made in the installation of the system. Improvement Permit with plat valid without expiration. Improvement Permit with site plan valid for sixty months. Authorization to Construct is valid for a period equal to that of Improvement Permit – not to exceed sixty months.

Signed: William J. Bell date 1-28-02 Installed by: Tommy Fuqua

Improvement Permit by: STEVE HEDRICK date 1-28-02 Operation Permit by: William O. Jackson date 7/14/03

Authorization to Construct by: STEVE HEDRICK date 1-28-02 Existing System Inspection by: date

HEALTH DEPT. COPY: WHITE OWNER COPY (FINAL): YELLOW OWNER COPY (INITIAL): PINK