# IREDELL COUNTY HEALTH DEPARTMENT

STATESVILLE 704-878-5305 CI MOORESVILLE 704-664-5281

## IMPROVEMENT PERMIT / AUTHORIZATION TO CONSTRUCT / OPERATION PERMIT / EXISTING SYSTEM INSPECTION

PERMIT# 095347 PIN# 4853-28-2968 DATE 04-08-02

OWNER OR CONTRACTOR PAM BUMGARNER PHONE Business Home 704-892-0554

ADDRESS 10210 BAILEY RD CORNELIUS, NC 28031

LOCATION HWY 901 WEST, (E) GRASSY KNOB RD, 1/4 mile on Rt ACROSS FROM ZEB RD

SUBDIVISION BLOCK / SECTION LOT LOT AREA 25.92 AC SITE CLASS 1B DESIGN FLOW 480 LTAR .3

Septic Tank: 1000 Gallons: STB 1012 Date 4-20-02
Pump Tank: Gallons: PT Date
Pump Make: Model Serial No B
Nitrification Field: No Fields 1 Square Feet 1600' Linear Feet 535
No Lines 4x133' Trench Width 36" Max Trench Bottom Depth 36 Gravel Depth 12"

X New System Repair System Type: I II III IV V VI
System Description: CONV GRAY
Repair System Description: CONV GRAY
Maintenance Agreement Required Yes X No
Slab X Crawl Space Basement w/plumbing Basement wo/plumbing

X House/Mod Home No Bedrooms 4
Mobile Home No Bathrooms 2½
Business No Employees
Other


Water Supply: X Individual ☐ Public ☐ Community

Comments/Conditions: (1) INSTALL LINES ON CONTOURS (2) KEEP WELL 100' AWAY FROM ~~WELL~~ SYSTEM (3) KEEP SYSTEM 5' off house & 10' off property lins minimum

Comments Conditions TUFF TITE FILTER & MARKER

INSTALLED AS DRAWN

INITIAL SITE SKETCH

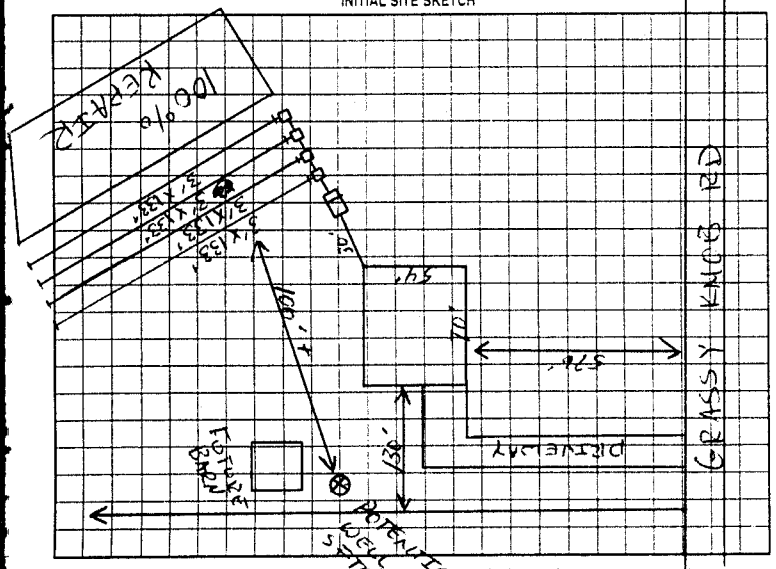


AS BUILT SKETCH

Permit can be suspended or revoked if any false information is supplied toward securing the permit, any unauthorized changes are made to the site, any unauthorized changes are made in the installation of the system. Improvement Permit with plat valid without expiration. Improvement Permit with site plan valid for sixty months. Authorization to Construct is valid for a period equal to that of Improvement Permit - not to exceed sixty months.

Signed: Pam Bumgarner date 4-8-02 Installed by: TOMMY FRYE

Improvement Permit by: date 04-08-02 Operation Permit by date 9-20-02

Authorization to Construct by: date 04-08-02 Existing System Inspection by date

HEALTH DEPT COPY WHITE OWNER COPY (FINAL) YELLOW OWNER COPY (INITIAL) PINK